

CARD MUST BE TYPED

State of Kansas  
**NOTICE OF INTENTION TO DRILL**  
(see rules on reverse side)

CARD MUST BE SIGNED

Starting Date: August 18, 1984  
month day year

API Number 15- 065-22,043-00-00

OPERATOR: License # 5242  
Name Petroleum Management, Inc.  
Address 400 N. Woodlawn, Suite 201  
City/State/Zip Wichita, KS 67208  
Contact Person Dale Silcott  
Phone 686-7287

NW NW SE Sec 12 Twp 6 S, Rge 21  
(location)  East  West

2310 Ft North from Southeast Corner of Section  
2310 Ft West from Southeast Corner of Section  
(Note: Locate well on Section Plat on reverse side)

CONTRACTOR: License # 5422  
Name Abercrombie Drilling Co.  
City/State Wichita, KS

Nearest lease or unit boundary line 330 feet.  
County Graham  
Lease Name Hoylman Well# 2

Domestic well within 330 feet:  yes  no  
Municipal well within one mile:  yes  no

Well Drilled For: Well Class: Type Equipment:  
 Oil  Swd  Infield  Mud Rotary  
 Gas  Inj  Pool Ext.  Air Rotary  
 OWWO  Expl  Wildcat  Cable

Depth to Bottom of fresh water 25.50 mhc feet  
Lowest usable water formation Dakota  
Depth to Bottom of usable water 1250 feet  
Surface pipe by Alternate: 1  2   
Surface pipe to be set 320 feet  
Conductor pipe if any required None feet  
Ground surface elevation 2118 feet MSL  
This Authorization Expires 2-9-85  
Approved By 8-9-84

If OWWO: old well info as follows:

Operator  
Well Name  
Comp Date Old Total Depth  
Projected Total Depth 3517 feet  
Projected Formation at TD Granite  
Expected Producing Formations Lansing-Kansas City

I certify that we will comply with K.S.A. 55-101, et seq., plus eventually plugging hole to K.C.C. specifications.


Date 8/7/84 Signature of Operator or Agent

*Dale Silcott* Title Vice President  
MHC/None 8/9/84

**Must be filed with the K.C.C. five (5) days prior to commencing well  
This card void if drilling not started within six (6) months of date received by K.C.C.**

**Important procedures to follow :**

**A Regular Section of Land  
1 Mile = 5,280 Ft.**

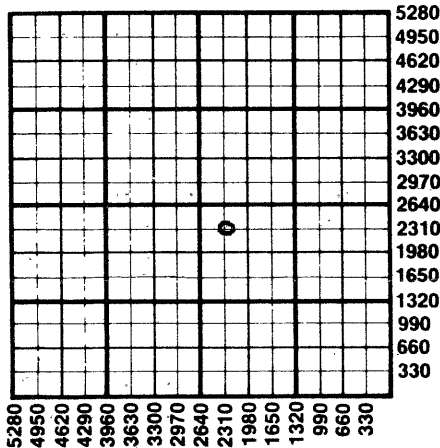

8-9-84

CONSERVATION DIVISION  
Wichita, Kansas

AUG 09 1984

RECEIVED  
STATE CORPORATION COMMISSION

1. Notify District office before setting surface casing.
2. Set surface casing by circulating cement to the top.
3. File completion forms ACO-1 with K.C.C. within 90 days of well completion, following instructions on ACO-1, side 1, and including copies of wireline logs.
4. Notify District office 48 hours prior to old well workover or re-entry.
5. Prior to plugging, prepare a plugging plan, then obtain agreement from the appropriate district office for an approved plugging plan.
6. Submit plugging report (CP-4) to K.C.C. after plugging is completed.
7. Obtain an approved injection docket number before disposing of salt water.
8. Notify K.C.C. within 10 days when injection commences or terminates.
9. If an alternate 2 completion, cement in the production pipe from below any usable water to surface within 120 days of spud date.

**State Corporation Commission of Kansas  
Conservation Division  
200 Colorado Derby Building  
Wichita, Kansas 67202  
(316) 263-3238**