

CARD MUST BE TYPED

State of Kansas

CARD MUST BE SIGNED

NOTICE OF INTENTION TO DRILL

(see rules on reverse side)

Starting Date 11/7/85
month day year

API Number 15- 065-22,259-00-00

OPERATOR: License # 5242
Name Petroleum Management, Inc.
Address 400 N. Woodlawn, Suite 201
City/State/Zip Wichita, KS 67208
Contact Person Dale Silcott
Phone 686-7287

SE 1/4 Sec. 10 Twp. 6S S, Rg. 21 East
1375 West
1500 Ft. from South Line of Section
Ft. from East Line of Section

(Note: Locate well on Section Plat on reverse side)

CONTRACTOR: License # 5302
Name Red Tiger Drilling Company
City/State Wichita, KS 67202

Nearest lease or unit boundary line 1375 feet
County Graham
Lease Name Holmquist Well # 2

Well Drilled For: Well Class: Type Equipment:
 Oil SWD Infield Mud Rotary
 Gas Inj Pool Ext. Air Rotary
 OWWO Expl Wildcat Cable

Ground surface elevation 2235 feet MSL
Domestic well within 330 feet: yes no
Municipal well within one mile: yes no
Surface pipe by Alternate: 1 2

If OWWO: old well info as follows:

Operator
Well Name
Comp Date Old Total Depth

Depth to bottom of fresh water 140 ft.
Depth to bottom of usable water 1125 ft.
Surface pipe planned to be set 360 ft.
Projected Total Depth 3800 ft.
Formation Toronto

I certify that well will comply with K.S.A. 55-101, et seq., plus eventually plugging hole to KCC specifications.

Cementing will be done immediately upon setting production casing
Date 10/25/85 Signature of Operator or Agent Dale Silcott Title Vice President

For KCC Use:


Conductor Pipe Required _____ feet; Minimum Surface Pipe Required _____ feet per Alt. 1 2
This Authorization Expires 4-30-86 Approved By 10-30-85 R

Must be filed with the K.C.C. five (5) days prior to commencing well
 This card void if drilling not started within six (6) months of date received by K.C.C.

Important procedures to follow:

1. Notify District office before setting surface casing.
2. Set surface casing by circulating cement to the top.
3. File completion forms ACO-1 with K.C.C. within 90 days of well completion, following instructions on ACO-1, side 1, and including copies of wireline logs.
4. Notify District office 48 hours prior to old well workover or re-entry.
5. Prior to filing Intent, prepare a proposed plugging plan in case well is D & A, then obtain approval of plan when calling district office prior to setting surface pipe.
6. Submit plugging report (CP-4) to K. C. C. after plugging is completed.
7. Obtain an approved injection docket number before disposing of salt water.
8. Notify K.C.C. within 10 days when injection commences or terminates.

A Regular Section of Land
1 Mile = 5,280 Ft.

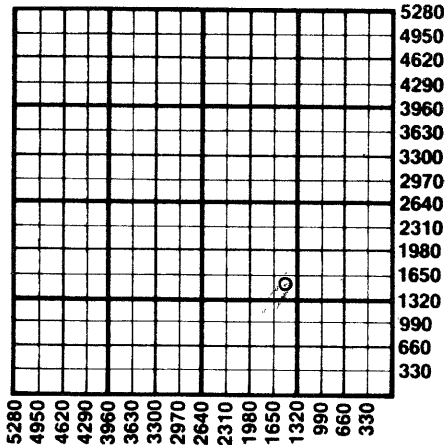

RECEIVED
 STATE CORPORATION COMMISSION

OCT 30 1988
 10-30-88
 CONSERVATION DIVISION
 Wichita, Kansas

9. If an alternate 2 completion, cement in the production pipe from below any usable water to surface within 120 days of spud date.

State Corporation Commission of Kansas
 Conservation Division
 200 Colorado Derby Building
 Wichita, Kansas 67202
 (316) 263-3238