

CARD MUST BE TYPED

State of Kansas
NOTICE OF INTENTION TO DRILL
(see rules on reverse side)

CARD MUST BE SIGNED

Starting Date: July 10 1985
month day year

OPERATOR: License # KC # 4411
Name BARDON ASSOCIATES, INC.
Address ROUTE 4 - BOX 65 F
City/State/Zip AUGUSTA, KS 67010
Contact Person DONALD ASH
Phone 775-3505 or 775-1248

CONTRACTOR: License # 5422
Name ABERCROMBIE DRILLING, INC.
City/State 801 Union Ctr. Wichita, Ks

Well Drilled For: Well Class: Type Equipment:
 Oil Swd Infield Mud Rotary
 Gas Inj Pool Ext. Air Rotary
 OWWO Expt Wildcat Cable

If OWWO: old well info as follows:

Operator
Well Name
Comp Date Old Total Depth
Projected Total Depth 3600 feet
Projected Formation at TD
Expected Producing Formations

I certify that we will comply with K.S.A. 55-101, et seq., plus eventually plugging hole to K.C.C. specifications.

Date 6-26-85 Signature of Operator or Agent Donald D. Ash Title President

API Number 15- 163-22,714-00-00

SE. SW. SE. (location) Sec 32. Twp .6.. S, Rge .19. East West

...330..... Ft North from Southeast Corner of Section
...1650..... Ft West from Southeast Corner of Section
(Note: Locate well on Section Plat on reverse side)

Nearest lease or unit boundary line 330 feet.
County ROOKS
Lease Name ... DESMARTEAU Well# 1

Domestic well within 330 feet : yes no
Municipal well within one mile : yes no

Depth to Bottom of fresh water 150 feet
Lowest usable water formation Dakota 150
Depth to Bottom of usable water 150 / 1000 feet
Surface pipe by Alternate : 1 2 225 feet
Surface pipe to be set
Conductor pipe if any required feet
Ground surface elevation .GL. ELEV. ... 2030 feet MSL
This Authorization Expires 12-26-85
Approved By 6-26-85 R.C.


Must be filed with the K.C.C. five (5) days prior to commencing well
This card void if drilling not started within six (6) months of date received by K.C.C.

RECEIVED
STATE CORPORATION COMMISSION

Important procedures to follow :

A Regular Section of Land
1 Mile = 5,280 Ft.

JUN 26 1985
06-26-1985
CONSERVATION DIVISION

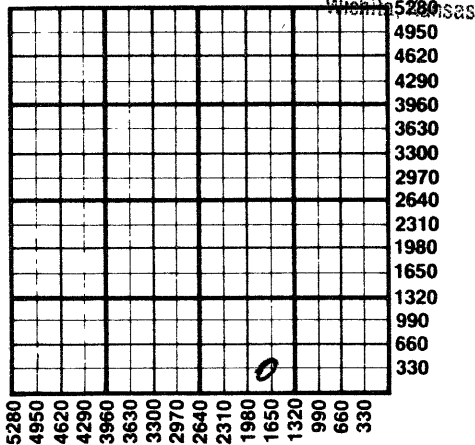

1. Notify District office before setting surface casing.
2. Set surface casing by circulating cement to the top.
3. File completion forms ACO-1 with K.C.C. within 90 days of well completion, following instructions on ACO-1, side 1, and including copies of wireline logs.
4. Notify District office 48 hours prior to old well workover or re-entry.
5. Prior to plugging, prepare a plugging plan, then obtain agreement from the appropriate district office for an approved plugging plan.
6. Submit plugging report (CP-4) to K.C.C. after plugging is completed.
7. Obtain an approved injection docket number before disposing of salt water.
8. Notify K.C.C. within 10 days when injection commences or terminates.
9. If an alternate 2 completion, cement in the production pipe from below any usable water to surface within 120 days of spud date.

State Corporation Commission of Kansas
Conservation Division
200 Colorado Derby Building
Wichita, Kansas 67202
(316) 263-3238