

CARD MUST BE TYPED

State of Kansas
NOTICE OF INTENTION TO DRILL

CARD MUST BE SIGNED

(see rules on reverse side)

Starting Date: September 1, 1985
month day year

API Number 15- 163-22,740-00-00

OPERATOR: License # 6278
PETX Petroleum Corporation
Name
Address 1616 Glenarm Pl. Suite 1700
City/State/Zip Denver, CO 80202
Contact Person Robert E. Johnson
Phone (303) 629-1098

SE SE SW (location) Sec 19 Twp 6 S, Rge 19
 East
 West

330 Ft North from Southeast Corner of Section
3045 Ft West from Southeast Corner of Section
(Note: Locate well on Section Plat on reverse side)

CONTRACTOR: License # 6033
Name Murfin Drilling Company
City/State Wichita, Ks.

Nearest lease or unit boundary line 330 feet.
County Rooks
Lease Name Earl Buss Well# 3

Well Drilled For: Well Class: Type Equipment:
 Oil Swd Infield Mud Rotary
 Gas Inj Pool Ext. Air Rotary
 OWWO Expl Wildcat Cable

Domestic well within 330 feet: yes no
Municipal well within one mile: yes no

Depth to Bottom of fresh water 150 feet
Lowest usable water formation Dakota
Depth to Bottom of usable water 1,000 feet
Surface pipe by Alternate: 1 2
Surface pipe to be set 300 feet
Conductor pipe if any required - - feet
Ground surface elevation 2111 feet MSL
This Authorization Expires 2-8-86
Approved By 8-8-85 RC

If OWWO: old well info as follows:

Operator
Well Name
Comp Date Old Total Depth
Projected Total Depth 3630 feet
Projected Formation at TD Granite
Expected Producing Formations Reagan

I certify that we will comply with K.S.A. 55-101, et seq., plus eventually plugging hole to K.C.C. specifications.


Date 8/6/85 Signature of Operator or Agent Robert E. Johnson Title President

RCIT FOR KONE

**Must be filed with the K.C.C. five (5) days prior to commencing well
This card void if drilling not started within six (6) months of date received by K.C.C.**

Important procedures to follow :

**A Regular Section of Land
1 Mile = 5,280 Ft.**

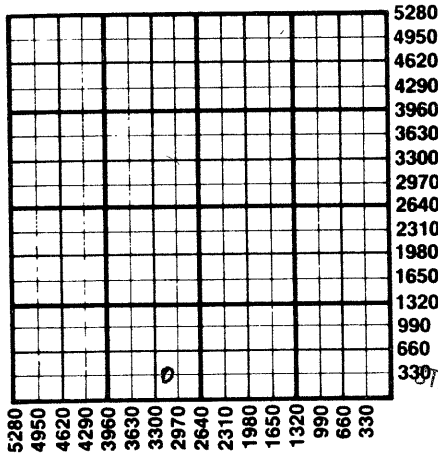

1. Notify District office before setting surface casing.
2. Set surface casing by circulating cement to the top.
3. File completion forms ACO-1 with K.C.C. within 90 days of well completion, following instructions on ACO-1, side 1, and including copies of wireline logs.
4. Notify District office 48 hours prior to old well workover or re-entry.
5. Prior to plugging, prepare a plugging plan, then obtain agreement from the appropriate district office for an approved plugging plan.
6. Submit plugging report (CP-4) to K.C.C. after plugging is completed.
7. Obtain an approved injection docket number before disposing of salt water.
8. Notify K.C.C. within 10 days when injection commences or terminates.
9. If an alternate 2 completion, cement in the production pipe from below any possible water to surface within 120 days of spud date.

RECEIVED
STATE CORPORATION COMMISSION

AUG 8 1965

CONSERVATION DIVISION
Wichita, Kansas

State Corporation Commission of Kansas
Conservation Division
200 Colorado Derby Building
Wichita, Kansas 67202
(316) 263-3238