

CARD MUST BE TYPED

State of Kansas
NOTICE OF INTENTION TO DRILL
(see rules on reverse side)

CARD MUST BE SIGNED

Starting Date: Nov. 10 1984
month day year

API Number 15- 163-22,557-00-00

OPERATOR: License # 5116
Name WellWin Drilling Corp.
Address P.O. Box 627
City/State/Zip Winfield, Ks. 67156
Contact Person John M. Rush
Phone (316)-221-3462

W/2, NW/4, SW/4 Sec 26. Twp. 6. S, Rge 19. East
(location) West

1980 Ft North from Southeast Corner of Section
4950 Ft West from Southeast Corner of Section
(Note: Locate well on Section Plat on reverse side)

CONTRACTOR: License #
Name unknown
City/State

Nearest lease or unit boundary line 330 feet.
County Rooks
Lease Name Stice Well# 26-1

Well Drilled For: Well Class: Type Equipment:
 Oil Swd Infield Mud Rotary
 Gas Inj Pool Ext. Air Rotary
 OWWO Expl Wildcat Cable

Domestic well within 330 feet: yes no
Municipal well within one mile: yes no

Depth to Bottom of fresh water feet
Lowest usable water formation Dakota feet
Depth to Bottom of usable water 925 feet
Surface pipe by Alternate: 1 2
Surface pipe to be set 200 200 feet
Conductor pipe if any required feet
Ground surface elevation 2055 feet MSL

This Authorization Expires 5-8-85
11-8-84 Approved By [Signature]

If OWWO: old well info as follows:

Operator
Well Name
Comp Date Old Total Depth
Projected Total Depth 3600 feet
Projected Formation at TD Arbuckle
Expected Producing Formations Topeka, Lkc., Arbuckle

I certify that we will comply with K.S.A. 55-101, et seq., plus eventually plugging hole to K.C.C. specifications.

Date 11/8/84 Signature of Operator or Agent [Signature]

Title GEORGE ISA
MHC/NOHE 11/8/84

CONSERVATION DIVISION
WICHITA, KANSAS


Must be filed with the K.C.C. five (5) days prior to commencing well
This card void if drilling not started within six (6) months of date received by K.C.C.

NOV 08 1984

11-08-1984

Important procedures to follow :

A Regular Section of Land
Under 100 Ft.

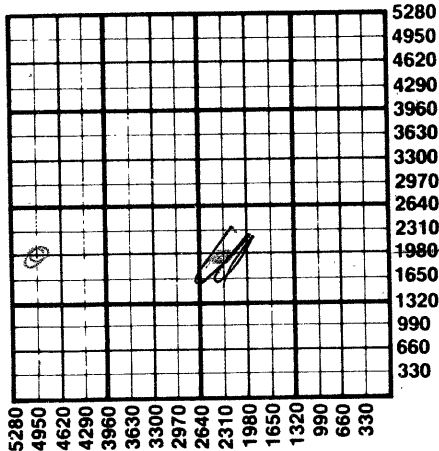

1. Notify District office before setting surface casing.
2. Set surface casing by circulating cement to the top.
3. File completion forms ACO-1 with K.C.C. within 90 days of well completion, following instructions on ACO-1, side 1, and including copies of wireline logs.
4. Notify District office 48 hours prior to old well workover or re-entry.
5. Prior to plugging, prepare a plugging plan, then obtain agreement from the appropriate district office for an approved plugging plan.
6. Submit plugging report (CP-4) to K.C.C. after plugging is completed.
7. Obtain an approved injection docket number before disposing of salt water.
8. Notify K.C.C. within 10 days when injection commences or terminates.
9. If an alternate 2 completion, cement in the production pipe from below any usable water to surface within 120 days of spud date.

State Corporation Commission of Kansas
Conservation Division
200 Colorado Derby Building
Wichita, Kansas 67202
(316) 263-3238