

COR

For KCC Use: Effective Date: 12-9-2000
District # 4
SGA? Yes No

KANSAS CORPORATION COMMISSION
OIL & GAS CONSERVATION DIVISION

Form C-1
September 1999
Form must be Typed
Form must be Signed
All blanks must be Filled

NOTICE OF INTENT TO DRILL

Must be approved by KCC five (5) days prior to commencing well

Expected Spud Date 1 12 2001
month day year

Spot NE SE East
NW NE SE Sec. 13 Twp. 6S S. R. 21W West
2310 feet from S / N (circle one) Line of Section
990 feet from E / W (circle one) Line of Section
Is SECTION Regular Irregular?

OPERATOR: License# 5011
Name: Viking Resources, Inc.
Address: 105 S. Broadway, Ste. 1040
City/State/Zip: Wichita, KS 67202
Contact Person: Shawn P. Devlin
Phone: 316-262-2502

(Note: Locate well on the Section Plat on reverse side)
County: Graham

CONTRACTOR: License# 30606
Name: Murfin Drilling, Inc.

* Lease Name: Nichol-Geyer Well #: 1
Field Name: Pioneer East

Well Drilled For: Oil Gas CWWD Seismic; # of Holes Other
Well Class: Enh Rec Storage Disposal Other
Type Equipment: Mud Rotary Air Rotary Cable
 Infield Pool Ext. Wildcat Other

Is this a Prorated / Spaced Field? Yes No
Target Formation(s): Arbuckle

Nearest Lease or unit boundary: 990
Ground Surface Elevation: 2242 feet MSL

Water well within one-quarter mile: Yes No
Public water supply well within one mile: Yes No

Depth to bottom of fresh water: 150
Depth to bottom of usable water: 960

Surface Pipe by Alternate: 1 2
Length of Surface Pipe Planned to be set: 200

Length of Conductor Pipe required: None
Projected Total Depth: 3900

Formation at Total Depth: Arbuckle
Water Source for Drilling Operations:

Well Farm Pond Other
DWR Permit #: _____

If OWWO: old well information as follows:
Operator: _____
Well Name: _____
Original Completion Date: _____ Original Total Depth: _____

Directional, Deviated or Horizontal wellbore? Yes No

If Yes, true vertical depth: _____

Bottom Hole Location: _____
KCC DKT #: _____

(Note: Apply for Permit with DWR)
Will Cores be taken? Yes No

If Yes, proposed zone: _____

WAS: GL. 2165; DEBIAN-BARBER #/

AFFIDAVIT

The undersigned hereby affirms that the drilling, completion and eventual plugging of this well will comply with K.S.A. 55-101, et. seq.
It is agreed that the following minimum requirements will be met:

1. Notify the appropriate district office **prior** to spudding of well;
2. A copy of the approved notice of intent to drill **shall be** posted on each drilling rig;
3. The minimum amount of surface pipe as specified below **shall be set** by circulating cement to the top; in all cases surface pipe **shall be set** through all unconsolidated materials plus a minimum of 20 feet into the underlying formation.
4. If the well is dry hole, an agreement between the operator and the district office on plug length and placement is necessary **prior to plugging**;
5. The appropriate district office will be notified before well is either plugged or production casing is cemented in;
6. If an ALTERNATE II COMPLETION, production pipe shall be cemented from below any usable water to surface within **120 days** of spud date. **In all cases, NOTIFY district office** prior to any cementing.

I hereby certify that the statements made herein are true and to the best of my knowledge and belief.

Date: 12-28-00 Signature of Operator or Agent: Shawn P. Devlin Title: Vice President

For KCC Use ONLY
API # 15 - 065-22806-0000
Conductor pipe required NONE feet
Minimum surface pipe required 200' feet per Alt. 2
Approved by: DPW 12-29-00/0816 JK 12-4-00
This authorization expires: 6-4-2001
(This authorization void if drilling not started within 6 months of effective date.)
Spud date: _____ Agent: _____

Remember to:

- File Drill Pit Application (form CDP-1) with Intent to Drill;
- File Completion Form ACO-1 within 120 days of spud date;
- File acreage attribution plat according to field proration orders;
- Notify appropriate district office 48 hours prior to workover or re-entry;
- Submit plugging report (CP-4) after plugging is completed;
- Obtain written approval before disposing or injecting salt water.

13
6
2/w

RECEIVED
KANSAS CORPORATION COMMISSION

Mail to: KCC - Conservation Division, 130 S. Market - Room 2078, Wichita, Kansas 67202

DEC 29 2000

CONSERVATION DIVISION
WICHITA, KS

IN ALL CASES PLOT THE INTENDED WELL ON THE PLAT BELOW

Plat of acreage attributable to a well in a prorated or spaced field

If the intended well is in a prorated or spaced field, please fully complete this side of the form. If the intended well is in a prorated or spaced field complete the plat below showing that the well will be properly located in relationship to other wells producing from the common source of supply. Please show all the wells and within 1 mile of the boundaries of the proposed acreage attribution unit for gas wells and within 1/2 mile of the boundaries of the proposed acreage attribution unit for oil wells.

API No. 15 - _____
 Operator: Viking Resources, Inc.
 Lease: Nichol-Geyer
 Well Number: 1
 Field: Pioneer-East
 Number of Acres attributable to well: _____
 QTR / QTR / QTR of acreage: NW-NE-SE - _____

Location of Well: County: Graham
2310 feet from S / N (circle one) Line of Section
990 feet from E / W (circle one) Line of Section
 Sec. 13 Twp. 6S S. R. 21W East West

Is Section X Regular or _____ Irregular


If Section is Irregular, locate well from nearest corner boundary.

Section corner used: NE NW X SE SW


PLAT

*(Show location of the well and shade attributable acreage for prorated or spaced wells.)
 (Show footage to the nearest lease or unit boundary line.)*

Rge 21W

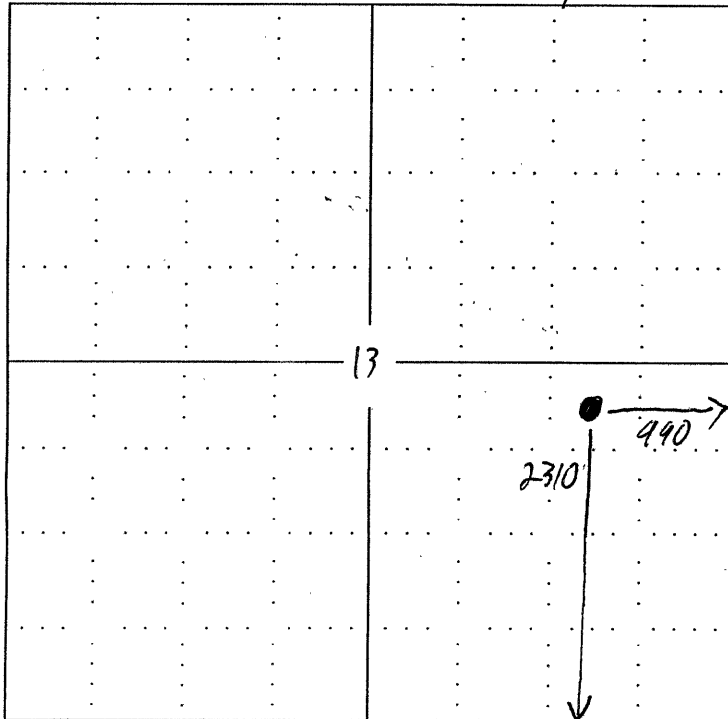

*Twp
6S*

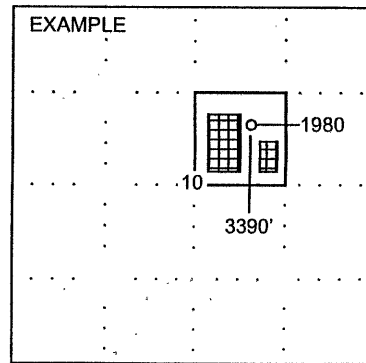

NOTE: In all cases locate the spot of the proposed drilling location.

In plotting the proposed location of the well, you must show:

1. The manner in which you are using the depicted plat by identifying section lines, i.e. 1 section, 1 section with 8 surrounding sections, 4 sections, etc.
2. The distance of the proposed drilling location from the section's south / north and east / west.
3. The distance to the nearest lease or unit boundary line.
4. If proposed location is located within a prorated or spaced field a certificate of acreage attribution plat must be attached: (CO-7 for oil wells; CG-8 for gas wells).