


15-065-21892-00-00

WELL PLUGGING RECORD

Give All Information Completely  
Make Required Affidavit

COUNTY Graham SEC. 11 TWP. 6S RGE. 21W E/W  
Location as in quarters or footage from lines:  
510' FEL & 870' FNL NE/4

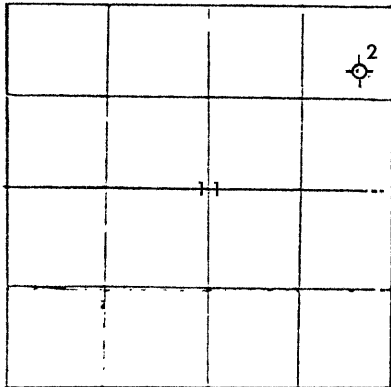

Locate Well  
correctly on above  
Section Plat.

Lease Owner Petroleum Management, Inc.  
Lease Name Lagerberg Well No. 2  
Office Address 400 N. Woodlawn, #201, Wichita, Ks. 67665  
Character of Well (Completed as Oil, Gas or Dry Hole): D & A  
Date Well Completed November 21, 1983  
Application for plugging filed November 21, 1983  
Plugging commenced November 21, 1983  
Plugging completed November 21, 1983  
Reason for abandonment of well or producing formation D & A

Was permission obtained from the Conservation Division or it's  
Agent's before plugging was commenced? Yes

Name of Conservation Agent who supervised plugging of this well David Wann  
Producing formation \_\_\_\_\_ Depth to top \_\_\_\_\_ bottom T.D. 3,813'  
Show depth and thickness of all water, oil and gas formations.


OIL, GAS OR WATER RECORDS

Casing Record

Formation	Content	From	To	Size	Put in	Pulled Out
				8 5/8"	363.80'	-0-

Describe in detail the manner in which the well was plugged, indicating where the mud fluid was placed and the method or methods used in introducing it into the hold. If cement or other plugs were used, state the character of same and depth placed, from \_\_\_\_\_ feet to \_\_\_\_\_ feet for each plug set.

- 1st Plug @ 1670' w/20 sx cement
- 2nd Plug @ 1020' w/100 sx cement
- 3rd Plug @ 410' w/40 sx cement
- 4th Plug @ 40' w/10 sx cement & seal
- 10 sx cement in rathole
- 50/50 Pozmix, 6% Gel, 3% C.C.

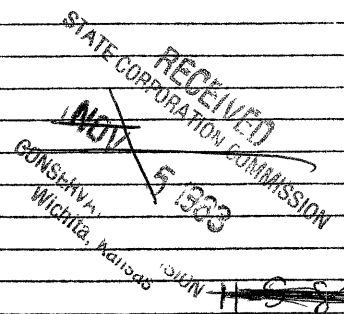

(If additional description is necessary, use BACK of this sheet) 12-5-83  
Name of Plugging Contractor Allied Cementing Co., Inc. DSS

STATE OF KANSAS COUNTY OF SEDGWICK, ss.  
Dale Silcott (employee of owner) or (owner or operator) of the  
above-described well, being first duly sworn on oath, says: That I have knowledge of the  
facts, statements, and matters herein contained and the log of the above-described well as  
filed and that the same are true and correct. So help me God.

(Signature) Dale Silcott  
400 N. Woodlawn, #201, Wichita, KS67208  
(Address)

SUBSCRIBED AND SWORN TO before me this 2nd day of Dec., 1983



Donnie Brown  
Notary Public.

My Commission expires: \_\_\_\_\_