

15-065-20071-00-00


STATE OF KANSAS  
STATE CORPORATION COMMISSION

Form CP-4

Give All Information Completely  
Make Required Affidavit  
Mail or Deliver Report to:  
Conservation Division  
State Corporation Commission  
211 No. Broadway  
Wichita, Kansas

WELL PLUGGING RECORD

NORTH

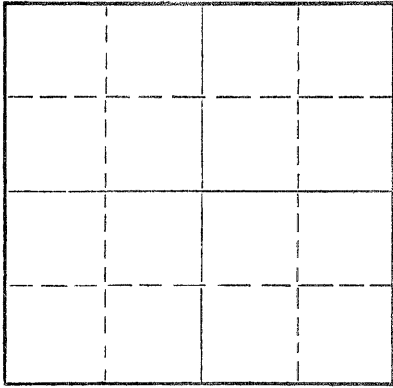

Locate well correctly on above  
Section Plat

Graham County, Sec. 30 Twp. 6S Rge. 21W (E) (W)  
Location as "NE/CNW/SW" or footage from lines NE NE NE  
Lease Owner Dunne-Gardner Petroleum, Inc.  
Lease Name Jacobson Well No. 1  
Office Address 300 Schweiter Bldg., Wichita, Kansas  
Character of Well (completed as Oil, Gas or Dry Hole) Dry Hole  
Date well completed August 8 19 67  
Application for plugging filed August 8 19 67  
Application for plugging approved August 8 19 67  
Plugging commenced August 8 19 67  
Plugging completed August 8 19 67  
Reason for abandonment of well or producing formation \_\_\_\_\_

If a producing well is abandoned, date of last production \_\_\_\_\_ 19\_\_\_\_  
Was permission obtained from the Conservation Division or its agents before plugging was commenced? yes

Name of Conservation Agent who supervised plugging of this well Bill Nichols  
Producing formation \_\_\_\_\_ Depth to top \_\_\_\_\_ Bottom \_\_\_\_\_ Total Depth of Well 3827 Feet  
Show depth and thickness of all water, oil and gas formations.

OIL, GAS OR WATER RECORDS

CASING RECORD

| FORMATION | CONTENT | FROM | TO | SIZE   | PUT IN | PULLED OUT |
|-----------|---------|------|----|--------|--------|------------|
|           |         |      |    | 8-5/8" | 202'   | -          |
|           |         |      |    |        |        |            |
|           |         |      |    |        |        |            |
Describe in detail the manner in which the well was plugged, indicating where the mud fluid was placed and the method or methods used in introducing it into the hole. If cement or other plugs were used, state the character of same and depth placed, from \_\_\_\_\_ feet to \_\_\_\_\_ feet for each plug set.

Mud to 1400', spotted with 100 sacks cement  
Mud to 210', plug, 20 sacks cement  
Mud to 40', 1/2 sack hulls, plug, 10 sacks cement

RECEIVED  
STATE CORPORATION COMMISSION

AUG 10 1967

CONSERVATION DIVISION  
WICHITA, KANSAS

8-10-67

(If additional description is necessary, use BACK of this sheet)

Name of Plugging Contractor \_\_\_\_\_  
Address \_\_\_\_\_

STATE OF KANSAS, COUNTY OF SEDGWICK, ss.

Don Gardner (employee of owner) or (owner or operator) of the above-described well, being first duly sworn on oath, says: That I have knowledge of the facts, statements, and matters herein contained and the log of the above-described well as filed and that the same are true and correct. So help me God.

(Signature) [Signature]  
300 Schweiter Bldg., Wichita, Kansas  
(Address)

SUBSCRIBED AND SWORN TO before me this 9th day of August, 19 67

My commission expires December 14, 1969

[Signature]  
Notary Public.