

15-163-30024-00-00


WELL PLUGGING RECORD

Give All Information Completely
Make Required Affidavit
Mail or Deliver Report to:
Conservation Division
State Corporation Commission
211 No. Broadway
Wichita, Kansas

Rooks County. Sec. 31 Twp. 6S Rge. 19W (E) (W)

Location as "NE/CNW $\frac{1}{4}$ SW $\frac{1}{4}$ " or footage from lines. NE NE SW
Lease Owner T. W. Jackson
Lease Name Ostmayer "A" Well No. 1
Office Address Phillipsburg, Kansas
Character of Well (completed as Oil, Gas or Dry Hole) Dry Hole
Date well completed June 17, 19 65
Application for plugging filed June 17, 19 65
Application for plugging approved June 17, 19 65
Plugging commenced June 17, 19 65
Plugging completed June 17, 19 65
Reason for abandonment of well or producing formation D & A

NORTH

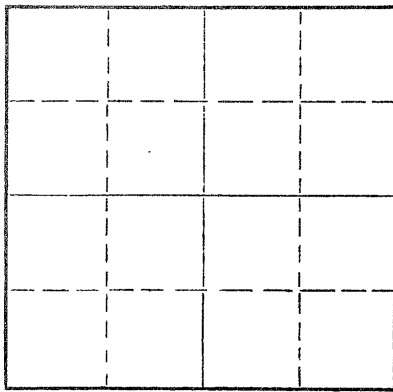

Locate well correctly on above
Section Plat

If a producing well is abandoned, date of last production 19
Was permission obtained from the Conservation Division or its agents before plugging was commenced? Yes

Name of Conservation Agent who supervised plugging of this well Eldon Petty
Producing formation Depth to top Bottom Total Depth of Well 3565 Feet
Show depth and thickness of all water, oil and gas formations.

OIL, GAS OR WATER RECORDS

CASING RECORD

| FORMATION | CONTENT | FROM | TO | SIZE | PUT IN | PULLED OUT |
|-----------|---------|------|----|--------|--------|------------|
| | | | | 8 5/8" | 217' | -0- |
| | | | | | | |
| | | | | | | |
| | | | | | | |
| | | | | | | |
| | | | | | | |
| | | | | | | |
| | | | | | | |

Describe in detail the manner in which the well was plugged, indicating where the mud fluid was placed and the method or methods used in introducing it into the hole. If cement or other plugs were used, state the character of same and depth placed, from feet to feet for each plug set.

Filled hole w/mud up to 540',
set plug, 20 sx cement; filled
hole up to 210', set plug, 20 sx
cement; filled hole up to 35',
set plug, 1/2 sack hulls, 10 sxs
cement. Plugged rathole with 2
sacks cement.

RECEIVED
STATE CORPORATION COMMISSION
JUL 1 1965
07-01-1965
CONSERVATION DIVISION
Wichita, Kansas

(If additional description is necessary, use BACK of this sheet)
Name of Plugging Contractor Red Tiger Drilling Company
Address Box 173 -- Russell, Kansas

STATE OF KANSAS, COUNTY OF SEDGWICK, ss.
Maxine V. Head (employee of owner) or (owner or operator) of the above-described well, being first duly sworn on oath, says: That I have knowledge of the facts, statements, and matters herein contained and the log of the above-described well as filed and that the same are true and correct. So help me God.

(Signature) Maxine V. Head
1720 Wichita Plaza, Wichita, Kansas
(Address)

SUBSCRIBED AND SWORN TO before me this 21st day of June, 19 65

Jean Kollar
Notary Public.