15-163-00114-00-00

STATE OF KANSAS
STATE CORPORATION COMMISSION

Give All Information Completely
Make Required Affidavit
Mail or Deliver Report to:
Conservation Division
State Corporation Commission
800 Bitting Building
Wichita, Kansas

WELL PLUGGING RECORD
OR
FORMATION PLUGGING RECORD

Strike out upper line when reporting plugging off formations.

NORTH

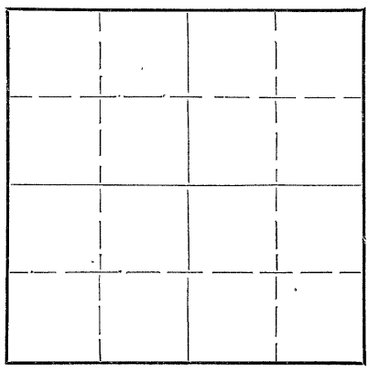

Locate well correctly on above Section Plat

Rooks County. Sec. 35 Twp. 6 Rge. (E) 19 (W)

Location as "NE¼NW¼SW¼" or footage from lines NE NE NE

Lease Owner Bridgeport Oil Company, Inc.

Lease Name Hindman Well No. 1

Office Address 914 Central Building, Wichita 2, Kansas

Character of Well (completed as Oil, Gas or Dry Hole) dry hole

Date well completed September 2, 19 48

Application for plugging filed September 7, 19 48

Application for plugging approved September 2, 19 48

Plugging commenced September 2, 19 48

Plugging completed September 2, 19 48

Reason for abandonment of well or producing formation dry hole

If a producing well is abandoned, date of last production 19

Was permission obtained from the Conservation Division or its agents before plugging was commenced? yes

Name of Conservation Agent who supervised plugging of this well M. A. Rives, Box 105, Hays, Kansas

Producing formation ..... Depth to top ..... Bottom ..... Total Depth of Well 3590 Feet

Show depth and thickness of all water, oil and gas formations.

OIL, GAS OR WATER RECORDS

Formation	Content	From	To	Size	Put In	Pulled Out
				8-5/8"	200'	none

CASING RECORD

Describe in detail the manner in which the well was plugged, indicating where the mud fluid was placed and the method or methods used in introducing it into the hole. If cement or other plugs were used, state the character of same and depth placed, from ..... feet to ..... feet for each plug set.

Filled hole with heavy mud from 3590' to 180'.
Placed bridge and 13 sacks cement at 180' to 145'. Filled with heavy mud from 145' to 25'.
Bridge and 7 sacks cement from 25' to base of cellar.

(If additional description is necessary, use BACK of this sheet)

RECEIVED
STATE CORPORATION COMMISSION
SEP 10 1948
09-10-1948

Correspondence regarding this well should be addressed to Bridgeport Oil Company, Inc.

Address 914 Central Building, Wichita 2, Kansas

STATE OF Kansas, COUNTY OF Sedgwick, ss.

Frank Leach (employee of owner) or (owner or operator) of the above-described well, being first duly sworn on oath, says: That I have knowledge of the facts, statements, and matters herein contained and the log of the above-described well as filed and that the same are true and correct. So help me God.

(Signature) Frank Leach

914 Central Building, Wichita 2, Kansas
(Address)

SUBSCRIBED AND SWORN TO before me this 9th day of September, 19 48

Martha Loepp
Notary Public.

My commission expires April 13, 1949.

22-2625 2-48—15M

PLUGGING
FILE SEC 35 T 6 R 19 W
BOOK PAGE 53 LINE 35