

15-163-21774-00-00


STATE OF KANSAS
STATE CORPORATION COMMISSION

WELL PLUGGING RECORD

Give All Information Completely
Make Required Affidavit
Mail or Deliver Report to
Conservation Division
State Corporation Comm.
245 North Water
Wichita, KS 67202

Rooks County, Sec. 31 Twp. 6 Rge. 19 E/W
Location as "NE/CNW $\frac{1}{4}$ SW $\frac{1}{4}$ " or footage from lines
C SE SE

Lease Owner Kenny Brown Enterprises
Lease Name Ostmyer C Well No. 1
Office Address P. O. Drawer 340, Plainville, KS 67663
Character of Well (Completed as Oil, Gas or Dry Hole)
Dry Hole

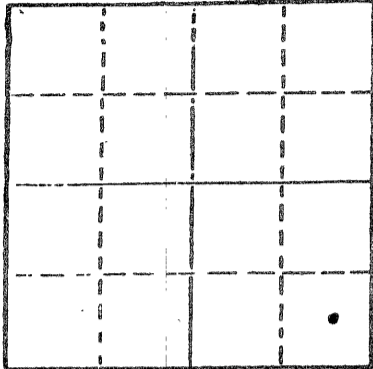

Locate well correctly on above
Section Plot

Date Well completed 10-7-1982
Application for plugging filed 10-7-1982
Application for plugging approved 10-7-1982
Plugging commenced 10-7-1982
Plugging completed 10-7-1982
Reason for abandonment of well or producing formation

If a producing well is abandoned, date of last production 19

Was permission obtained from the Conservation Division or its agents before plugging was commenced? Yes

Name of Conservation Agent who supervised plugging of this well Marion Schmidt
Producing formation Depth to top Bottom Total Depth of Well 3264'
Show depth and thickness of all water, oil and gas formations.

OIL, GAS OR WATER RECORDS

CASING RECORD

FORMATION	CONTENT	FROM	TO	SIZE	PUT IN	PULLED OUT
				8 5/8"	181'	-0-

Describe in detail the manner in which the well was plugged, indicating where the mud fluid was placed and the method or methods used in introducing it into the hold. If cement or other plugs were used, state the character of same and depth placed, from feet to feet for each plug set.

1st plug was set at 930' with 100 sacks cement
2nd plug was set at 240' with 40 sacks cement
3rd plug was set at 40' with 10 sacks cement


(If additional description is necessary, use BACK of this sheet)

Name of Plugging Contractor Dreiling Oil, Inc., Victoria, KS 67671

STATE OF Kansas COUNTY OF Rooks, ss.
I, Kenneth O Brown (employee of owner) or (owner or operator)
of the above-described well, being first duly sworn on oath, says: That I have knowledge of the facts, statements, and matters herein contained and the log of the above-described well as filed and that the same are true and correct. So help me God.

(Signature) *Kenneth O Brown*
Drawer 340, Plainville, Mo. 67663
(Address)

SUBSCRIBED AND SWORN to before me this 12th day of October, 1982

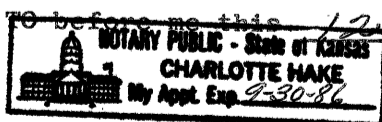

Charlotte Hake
Notary Public.

My commission expires

RECEIVED
STATE CORPORATION COMMISSION

OCT 13 1982
10-13-1982
CONSERVATION DIVISION
Wichita, Kansas