


WELL PLUGGING RECORD

Give All Information Completely
Make Required Affidavit
Mail or Deliver Report to:
Conservation Division
State Corporation Commission
800 Biting Building
Wichita, Kansas

Rooks County. Sec. 30 Twp. 6 Rge. 19 (E) (W)

NORTH

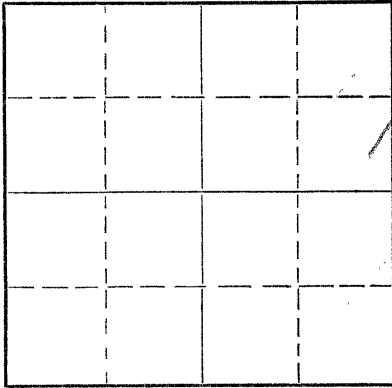

Locate well correctly on above Section Plat

Location as "NE/CNW $\frac{1}{4}$ SW $\frac{1}{4}$ " or footage from lines SW NE
 Lease Owner Francis Oil & Gas Company
 Lease Name Dryden Well No. 1
 Office Address 902 Palace Building, Tulsa, Oklahoma
 Character of Well (completed as Oil, Gas or Dry Hole) Dry Hole
 Date well completed September 26 19 53
 Application for plugging filed September 26 19 53
 Application for plugging approved September 26 19 53
 Plugging commenced September 26 19 53
 Plugging completed September 26 19 53
 Reason for abandonment of well or producing formation Dry Hole

If a producing well is abandoned, date of last production _____ 19____
 Was permission obtained from the Conservation Division or its agents before plugging was commenced? Yes

Name of Conservation Agent who supervised plugging of this well Eldon Petty, Hays, Kansas
 Producing formation _____ Depth to top _____ Bottom _____ Total Depth of Well 3650 Feet
 Show depth and thickness of all water, oil and gas formations.

OIL, GAS OR WATER RECORDS

CASING RECORD

FORMATION	CONTENT	FROM	TO	SIZE	PUT IN	PULLED OUT
				8 5/8"	155'	

Describe in detail the manner in which the well was plugged, indicating where the mud fluid was placed and the method or methods used in introducing it into the hole. If cement or other plugs were used, state the character of same and depth placed, from _____ feet to _____ feet for each plug set.

Bottom plug set at 150' - used 1/2 sack hulls and 15 sacks cement-
 filled with mud to 40' - used Halliburton plug - 1/2 sack hulls and 10
 sacks cement.

(If additional description is necessary, use BACK of this sheet)

Name of Plugging Contractor The Veeder Supply and Development Company
 Address P. O. Box 201, Cherryvale, Kansas

STATE OF Kansas, COUNTY OF Montgomery, ss.
Floyd W. Hild (employee of owner) or ~~(owner or operator)~~ of the above-described well, being first duly sworn on oath, says: That I have knowledge of the facts, statements, and matters herein contained and the log of the above-described well as filed and that the same are true and correct. So help me God.

(Signature) Floyd W. Hild
Cherryvale, Kansas
 (Address)

SUBSCRIBED AND SWORN TO before me this 29th day of September 19 53

My commission expires July 11, 1956 _____
Lois Lawson
 Notary Public.

PLUGGING
 FILE SEC 30 T. 6 R. 19
 BOOK PAGE 132 LINE 21

STATE OF KANSAS
 10-07-1953
 WICHITA, KANSAS

15-163-00643-00-00

Veeder Supply & Dev'l. Co.



Cherryvale, Kansas

Francis Oil & Gas Company

Drilled for Herman Kaiser Farm Dryden No. 1 Depth 3650'
 Contractor Veeder Supply & Development Company Pipe Run 166' of 8 5/8" casing
Cemented w/125 sacks cement.
 Location SW NE Sec. 30 Twp. 6 Range 19
 Commenced 9-17-1953 Completed 9-26-1953 County _____ Rooks State Kansas

Clay, soil	0	45	45
Sand	45	60	15
Shale	60	250	190
Shale, shells	250	500	250
Shells	500	700	200
Shale, sand streaks	700	1100	400
Shale	1100	1200	100
Sand, shale	1200	1390	190
Shale, shells	1390	1656	266
Anhydrite	1656	1689	33
Shale, shells	1689	2340	651
Lime, shale	2340	2815	475
Shale, lime shells	2815	3085	270
Lime	3085	3550	465
Lime, shale, chert	3550	3599	49
Lime	3599	3650	51
Total Depth	3650		

Plugged with heavy mud to 140' with 15 sacks cement.
 Plugged with heavy mud to 40' with 10 sacks cement.

AFFIDAVIT

STATE OF KANSAS)
 Montgomery County) SS

Floyd W. Hild, of lawful age, being duly and solemnly sworn on oath,
 deposes and says:

I am a resident of Cherryvale, Montgomery County, Kansas, and I hereby
 know and on oath state that the above drilling log covering the Dryden Well #1,
 in Section 306-19, Rooks County, Kansas, is true and correct. Further affiant
 saith not.

THE VEEDER SUPPLY AND DEVELOPMENT COMPANY

By Floyd W. Hild
 Floyd W. Hild

Subscribed and sworn to before me this 29th day of September, 1953.

Lois Lawson
 Notary Public

My commission expires July 11, 1956.

PLUGGING
 FILE SEC 30 T 6 R 19W
 PAGE 132 LINE 21

RECEIVED
 STATE COOPERATION COMMISSION
 OCT - 7 1953
 10-07-1953
 CONSERVATION DIVISION
 Wichita, Kansas