

STATE OF KANSAS
STATE CORPORATION COMMISSION


WELL PLUGGING RECORD

API NUMBER 15-163-20,960-00-00

Give All Information Completely
Make Required Affidavit
Mail or Deliver Report to
Conservation Division
State Corporation Comm.
245 North Water
Wichita, KS 67202

Rooks _____ County. Sec. 26 Twp. 6S Rge. 19 E/W
Location as "NE/CNW 1/4 SW 1/4" or footage from lines _____
C SW NW

Lease Owner Cinco Exploration Company
Lease Name Fleming Well No. #1-26
Office Address Box 3723 Victoria, Texas 77901
Character of Well (Completed as Oil, Gas or Dry Hole) _____

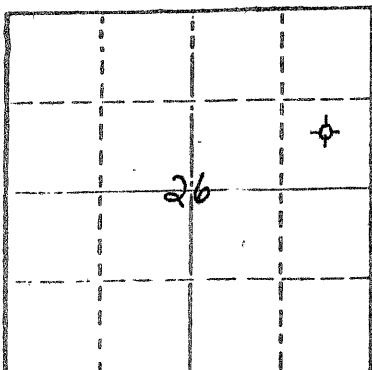

Locate well correctly on above Section Plot

Dry Hole
Date Well completed August 24, 19 79
Application for plugging filed August 24 19 79
Application for plugging approved August 24 19 79
Plugging commenced August 24, 10:00 A.M. 19 79
Plugging completed August 24, 11:30 A.M. 19 79
Reason for abandonment of well or producing formation _____

No Commercial Production
If a producing well is abandoned, date of last production _____ 19 _____

Was permission obtained from the Conservation Division or its agents before plugging was commenced? Yes

Name of Conservation Agent who supervised plugging of this well _____
Producing formation _____ Depth to top _____ Bottom _____ Total Depth of Well 3605'
Show depth and thickness of all water, oil and gas formations.

OIL, GAS OR WATER RECORDS

CASING RECORD

FORMATION	CONTENT	FROM	TO	SIZE	PUT IN	PULLED OUT
surface casing	60-40 poz	0	200.36'	8-5/8"	200.36	0

Describe in detail the manner in which the well was plugged, indicating where the mud fluid was placed and the method or methods used in introducing it into the hold. If cement or other plugs were used, state the character of same and depth placed, from _____ feet to _____ feet for each plug set.

Plug #1 @ 970' with 70 sxs
Plug #2 @ 190' with 20 sxs
Plug #3 @ 40' with 10 sxs
60-40 poz 6% gel
5 sxs in rat hole

RECEIVED
STATE CORPORATION COMMISSION
SEP 10 1979
WICHITA, KANSAS

(If additional description is necessary, use BACK of this sheet)

Name of Plugging Contractor Pioneer Drilling Company, Inc.
308 West Mill Plainville, Kansas 66763

STATE OF Texas COUNTY OF Victoria, ss.
Melvin Klotzman - Petroleum Consultant (employee of xxxxxxxxx xxxxxxxxx operator)

of the above-described well, being first duly sworn on oath, says: That I have knowledge of the facts, statements, and matters herein contained and the log of the above-described well as filed and that the same are true and correct. So help me God.

(Signature) _____
MELVIN KLOTZMAN
P.O. Box 3723 Victoria, Tx.
(Address)

SUBSCRIBED AND SWORN TO before me this 5 day of September, 19 79

My commission expires 3-9-81

Notary Public.