


Give All Information Completely
Make Required Affidavit
Mail or Deliver Report to:
Conservation Division
State Corporation Commission
211 No. Broadway
Wichita, Kansas

WELL PLUGGING RECORD

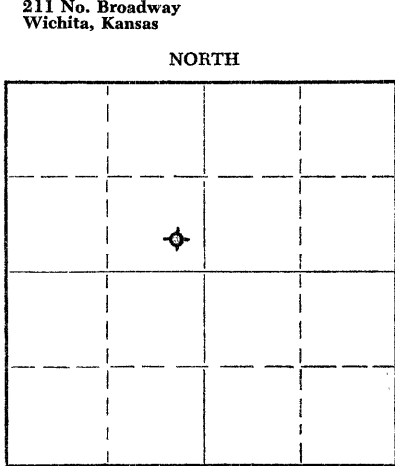

Locate well correctly on above
Section Plat

Rooks County. Sec. 24 Twp. 6S Rge. 19 ~~(E)~~ (W)
Location as "NE/CNW/SE/SW" or footage from lines SE SE NW
Lease Owner Powell Drilling Company
Lease Name Roy K. Waters Well No. 1
Office Address 412 Union Center Building, Wichita, Kansas
Character of Well (completed as Oil, Gas or Dry Hole) Dry Hole
Date well completed April 24, 1957
Application for plugging filed April 24, 1957
Application for plugging approved April 24, 1957
Plugging commenced April 25, 1957
Plugging completed April 25, 1957
Reason for abandonment of well or producing formation Dry Hole

If a producing well is abandoned, date of last production _____ 19____
Was permission obtained from the Conservation Division or its agents before plugging was commenced? Yes

Name of Conservation Agent who supervised plugging of this well Eldon Petty
Producing formation None Depth to top _____ Bottom _____ Total Depth of Well 3688 Feet
Show depth and thickness of all water, oil and gas formations.

OIL, GAS OR WATER RECORDS

CASING RECORD

FORMATION	CONTENT	FROM	TO	SIZE	PUT IN	PULLED OUT
Surface Casing		0	200'	8-5/8	200'	none

Describe in detail the manner in which the well was plugged, indicating where the mud fluid was placed and the method or methods used in introducing it into the hole. If cement or other plugs were used, state the character of same and depth placed, from 3688 feet to 0 feet for each plug set.

Mud to 195' - plug, 1/2 hulls - 20 sacks cement, to 40';
Mud 1/2 sack hulls - 10 sacks cement to 5' -- heavy mud
to surface

(If additional description is necessary, use BACK of this sheet)

Name of Plugging Contractor Powell Drilling Company
Address 412 Union Center Building, Wichita, Kansas

STATE OF Kansas, COUNTY OF Sedgwick, ss.
C. M. Powell, Jr. (employee of owner) or (owner or operator) of the above-described well, being first duly sworn on oath, says: That I have knowledge of the facts, statements, and matters herein contained and the log of the above-described well as filed and that the same are true and correct. So help me God.

(Signature) [Signature]
(Address) _____

SUBSCRIBED AND SWORN TO before me this 26th day of April, 19 57

My commission expires October 13, 1960

Lorraine M. Johnson
Notary Public.

PLUGGING
FILE SEC 24 T. 6 1957
BOOK PAGE 9 LINE 28

FILED
CORPORATION COMMISSION
04-30-1957
APR 30 1957
CONSERVATION DIVISION
Wichita, Kansas