

ORIGINAL

STATE CORPORATION COMMISSION OF KANSAS
OIL & GAS CONSERVATION DIVISION
RECOMPLETION FORM
ACC-2 AMENDMENT TO WELL HISTORY

API NO. 15- 163-21,268-00-01

Operator: License # 5537
Name Kenny Brown Enterprises
Address Drawer 340
Plainville, Kansas 67663
City/State/Zip

County Rooks
C/S2 SE/4 NW/4 Sec 36 Twp 6 Rge 20 East
2970 Ft North from Southeast Corner of Section
3300 Ft West from Southeast Corner of Section
(Note: Locate well in section plat below)

Purchaser Clear Creek

Lease Name Wills Well # 2

Operator Contact Person Kenneth O Brown
Phone 913-434-7236


Field Name Slate

Name of New Formation K City (C and E)

Designate Type of Original Completion
 New Well Re-Entry Workover
 Oil SWD Temp Abd
 Gas Inj Delayed Comp.
 Dry Other (Core, Water Supply etc.)

Elevation: Ground 2089 KB 2094
Section Plat

Date of Original Completion: 4-27-81

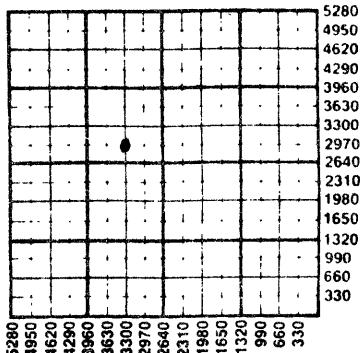

DATE OF RECOMPLETION:
3-4-91 3-5-91
Commenced Completed

Designate Type of Recompletion/Workover:
 Deepening Delayed Completion
 Plug Back Re-perforation

Is recompleted production:
 Commingled; Docket No. _____
 Dual Completion; Docket No. _____
 Other (Disposal or Injection)? _____

RECEIVED
STATE CORPORATION COMMISSION

APR 08 1991

CONSERVATION DIVISION
Wichita, Kansas

K.C.C. OFFICE USE ONLY
F Letter of Confidentiality Attached
W Wireline Log Received
D Drillers Timelog Received
Distribution
 KCC SWD/Rep NGPA
 KGS Plug Other
(Specify)

RECEIVED
STATE CORPORATION COMMISSION


APR 08 1991

CONSERVATION DIVISION
Wichita, Kansas

INSTRUCTIONS: This form shall be completed in triplicate and filed with the Kansas Corporation Commission, 200 Colorado Derby Building, Wichita, Kansas 67202, within 120 days of the recompletion of any well. Rules 82-3-107 and 82-3-141 apply. Information on side two of this form will be held confidential for a period of 12 months if requested in writing and submitted with the form. See rule 82-3-107 for confidentiality in excess of 12 months. One copy of any additional wireline logs and driller's time logs (not previously submitted) shall be attached with this form. Submit ACC-4 prior to or with this form for approval of commingling or dual completions. Submit CP-4 with all plugged wells. Submit CP-111 with all temporarily abandoned wells. NOTE: Conversion of wells to either disposal or injection must receive approval before use; submit form U-1.

All requirements of the statutes, rules and regulations promulgated to regulate the oil and gas industry have been fully complied with and the statements herein are complete and correct to the best of my knowledge.

Signature Kenneth O Brown Title owner & operator Date 4-4-91
Subscribed and sworn to before me this 4th day of April 19 91
Notary Public Barbara West Date Commission Expires 5-27-91

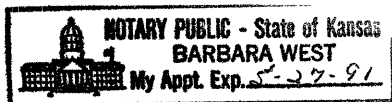

PI

perforated
2 new 30 new

SIDE TWO

Operator Name Kenneth O Brown Lease Name Wills Well # 2

Sec 36 Twp 6 Rge 20 East West County Rooks County, Kansas

RECOMPLETED FORMATION DESCRIPTION:

Log Sample

Name	Top	Bottom
Kansas City	3398	3396
Kansas City	3360	3358

ADDITIONAL CEMENTING/SQUEEZE RECORD					
Purpose:	Depth		Type of Cement	# Sacks Used	Type & Percent Additives
	Top	Bottom			
<input type="checkbox"/> Perforate					
<input type="checkbox"/> Protect Casing					
<input type="checkbox"/> Plug Back TD					
<input type="checkbox"/> Plug Off Zone					

Shots Per Foot	PERFORATION RECORD	Acid, Fracture, Shot, Cement Squeeze Record
	Specify Footage of Each Interval Perforated	(Amount and Kind of Material Used)
<u>4</u>	<u>3396-3398'</u>	<u>1500 gal 15% reg acid</u>
<u>4</u>	<u>3358-3360'</u>	<u>1500 gal 15% reg acid</u>

PBTD _____ Plug Type _____

TUBING RECORD:

Size 2 3/8" Set At 3570.50 Packer At _____ Was Liner Run? Y N

Date of Resumed Production, Disposal or Injection 3-7-91

Estimated Production Per 24 Hours 40 bbl/oil 23 bbl/water
 _____ MCF gas _____ gas-oil ratio