

CARD MUST BE TYPED

State of Kansas

CARD MUST BE SIGNED

### NOTICE OF INTENTION TO DRILL

(see rules on reverse side)

Expected Spud Date. 12-26-87  
month day year

API Number 15- 163-22,976-0000  
Irregular Section  
NW SE SW Sec. 30 Twp. 6 S, Rg. 20 X East  
West  
970 Ft. from South Line of Section  
3370 Ft. from East Line of Section

OPERATOR: License # 4767  
Name Ritchie Exploration, Inc.  
Address 125 N. Market, Suite 1000  
City/State/Zip Wichita, KS 67202  
Contact Person Jeff Christian  
Phone 316/267-4375

(Note: Locate well on Section Plat on reverse side)  
Nearest lease or unit boundary line 730 feet  
County Rooks  
Lease Name LOUIS VOSS Well # 1  
Ground surface elevation 2271 feet MSL  
Domestic well within 330 feet: no X yes  
Municipal well within one mile: no X yes

CONTRACTOR: License # 6033  
Name Murfin Drilling Company  
City/State Wichita, Kansas

Well Drilled For: Well Class: Type Equipment:  
X Oil Storage Infield X Mud Rotary  
Gas Inj Pool Ext. Air Rotary  
OWWO X Expl X Wildcat Cable

Depth to bottom of fresh water. 100'  
Depth to bottom of usable water 1275'  
Surface pipe by Alternate: 1 2 X  
Surface pipe planned to be set 240'  
Conductor pipe required  
Projected Total Depth 3800 feet  
Formation Arbuckle

If OWWO: old well info as follows:  
Operator  
Well Name  
Comp Date Old Total Depth

I certify that well will comply with K.S.A. 55-101, et seq., plus eventually plugging hole to KCC specifications.  
Date 12/21/87 Signature of Operator or Agent Jeff Christian Title Geologist

For KCC Use:  
Conductor Pipe Required feet; Minimum Surface Pipe Required feet per Alt. 200 (X) 2  
This Authorization Expires 6-21-88 Approved By Per 12-21-87


EFFECTIVE DATE: 12-26-87

Must be filed with the K.C.C. five (5) days prior to commencing well  
 This card void if drilling not started within six (6) months of date received by K.C.C.

**Important procedures to follow:**

1. Notify District office before setting surface casing.
  2. Set surface casing by circulating cement to the top.
  3. File completion forms ACO-1 with K.C.C. within 120 days of well spud date, following instructions on ACO-1, side 1, and including copies of wireline logs.
  4. Notify District office 48 hours prior to old well workover or re-entry.
  5. Prior to filing Intent, prepare a proposed plugging plan in case well is D & A, then obtain approval of plan when calling district office prior to setting surface pipe.
  6. Submit plugging report (CP-4) to K.C.C. after plugging is completed.
  7. Obtain an approved injection docket number before disposing of salt water.
- File completion forms ACO-1 with K.C.C. within 10 days when injection commences or terminates.

**A Regular Section of Land**  
**1 Mile = 5,280 Ft.**

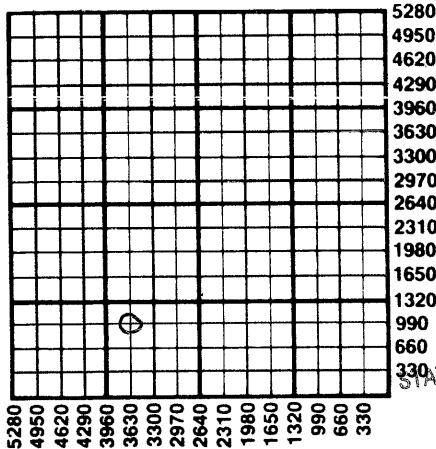

RECEIVED  
 STATE CORPORATION COMMISSION

DEC 21 1987

CONSERVATION DIVISION  
 Wichita, Kansas

12-21-87

an alternate 2 completion, cement in the production pipe from  
 below any usable water to surface within 120 days of spud date.

State Corporation Commission of Kansas  
 Conservation Division  
 200 Colorado Derby Building  
 Wichita, Kansas 67202-1212  
 (316) 263-3238