

CARD MUST BE TYPED

State of Kansas

CARD MUST BE SIGNED

NOTICE OF INTENTION TO DRILL

(see rules on reverse side)

Starting Date November 18, 1985
month day year

API Number 15— 065-22,268-00-00

OPERATOR: License # 8000
Name PanCanadian Petroleum Co.
Address 600 17th St., #1800-S
City/State/Zip Denver, CO 80202
Contact Person Tom Rubis
Phone 303 825 8371

_____ East
C SW SE Sec. 17 Twp. 6S, Rg. 22 X West
..... 660 Ft. from South Line of Section
..... 1980 Ft. from East Line of Section

(Note: Locate well on Section Plat on reverse side)

CONTRACTOR: License # 9087
Name R. & C. Drilling Co. Inc.
City/State Box 296, Hays, KS 67601

Nearest lease or unit boundary line 660 feet
County Graham
Lease Name Schuck 34-17 Well # 3

Well Drilled For: Well Class: Type Equipment:
X Oil _____ SWD _____ Infield X Mud Rotary
_____ Gas _____ Inj X Pool Ext. _____ Air Rotary
_____ OWWO _____ Expl _____ Wildcat _____ Cable

Ground surface elevation feet MSL
Domestic well within 330 feet: _____ yes X no
Municipal well within one mile: _____ yes X no
Surface pipe by Alternate: 1 X 2 _____

If OWWO: old well info as follows:
Operator
Well Name
Comp Date Old Total Depth

Depth to bottom of fresh water 200
Depth to bottom of usable water 1225
Surface pipe planned to be set 280
Projected Total Depth 4000 feet
Formation Arbuckle

I certify that well will comply with K.S.A. 55-101, et seq., plus eventually plugging hole to KCC specifications.

XX _____ cementing will be done immediately upon setting production casing.

Rec'd 11/12/85

Date 11/12/85 Signature of Operator or Agent Edaine Burkman Title as agent

For KCC Use:

Conductor Pipe Required feet; Minimum Surface Pipe Required feet per Alt. 1 2

This Authorization Expires 5-12-86 Approved By 11-12-85 EC

RECEIVED

STATE CORPORATION COMMISSION
This card void if drilling not started within six (6) months of date received by K.C.C.

Must be filed with the K.C.C. five (5) days prior to commencing well

NOV 17 1985


11-12-85

CONSERVATION DIVISION

Wichita, Kansas

A Regular Section of Land

1 Mile = 5,280 Ft.

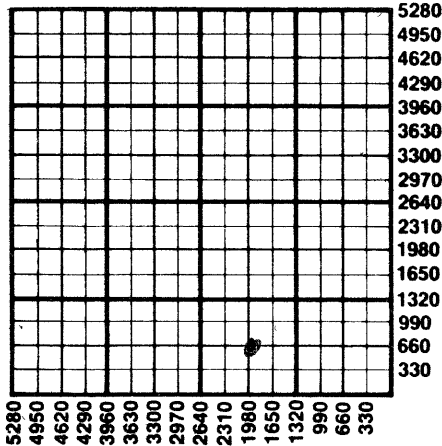

Important procedures to follow:

1. Notify District office before setting surface casing.
2. Set surface casing by circulating cement to the top.
3. File completion forms ACO-1 with K.C.C. within 90 days of well completion, following instructions on ACO-1, side 1, and including copies of wireline logs.
4. Notify District office 48 hours prior to old well workover or re-entry.
5. Prior to filing Intent, prepare a proposed plugging plan in case well is D & A, then obtain approval of plan when calling district office prior to setting surface pipe.
6. Submit plugging report (CP-4) to K.C.C. after plugging is completed.
7. Obtain an approved injection docket number before disposing of salt water.
8. Notify K.C.C. within 10 days when injection commences or terminates.
9. If an alternate 2 completion, cement in the production pipe from below any usable water to surface within 120 days of spud date.

State Corporation Commission of Kansas
Conservation Division
200 Colorado Derby Building
Wichita, Kansas 67202
(316) 263-3238