

30340  
15-163-30304-00-00  
WELL PLUGGING RECORD


STATE OF KANSAS  
STATE CORPORATION COMMISSION

Give All Information Completely  
Make Required Affidavit  
Mail or Deliver Report to:  
Conservation Division  
State Corporation Commission  
800 Biting Building  
Wichita, Kansas

OR  
FORMATION PLUGGING RECORD

Strike out upper line  
when reporting plug-  
ging off formations.

NORTH

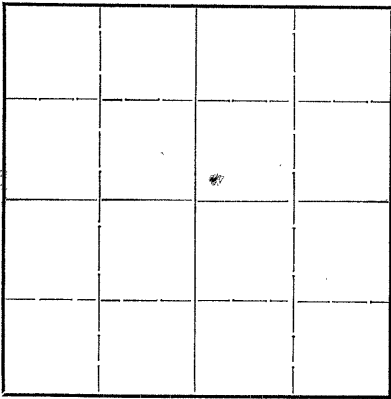

Locate well correctly on above  
Section Plat

Rooks \_\_\_\_\_ County. Sec. 5 Twp. 6 Rge. (E) 12 (W)  
Location as "NE $\frac{1}{4}$ NW $\frac{1}{4}$ SW $\frac{1}{4}$ " or footage from lines 330 N 330 E From Center  
Lease Owner Cities Service Oil Company  
Lease Name Johnston Well No. 1  
Office Address Bartlesville, Oklahoma.  
Character of Well (completed as Oil, Gas or Dry Hole) Dry Hole  
Date, well completed December 5, 1940 19  
Application for plugging filed December 5, 1940 19  
Application for plugging approved December 5, 1940 19  
Plugging Commenced December 5, 1940 19  
Plugging Completed December 5, 1940 19  
Reason for abandonment of well or producing formation Dry Hole

If a producing well is abandoned, date of last production \_\_\_\_\_ 19  
Was permission obtained from the Conservation Division or its agents before plugging was com-  
menced? Yes

Name of Conservation Agent who supervised plugging of this well G. T. Alexander  
Producing formation Granite Depth to top 3669' Bottom \_\_\_\_\_ Total Depth of Well 3670' Feet  
Show depth and thickness of all water, oil and gas formations.

OIL, GAS OR WATER RECORDS

CASING RECORD

Formation	Content	From	Size	Size	Put In	Pulled Out
Granite	Dry		<del>8 5/8</del> 10 7/8	122' 8 5/8"	122'	None

Describe in detail the manner in which the well was plugged, indicating where the mud fluid was placed and the method or methods used in introducing it into the hole. If cement or other plugs were used, state the character of same and depth placed, from \_\_\_\_\_ feet to \_\_\_\_\_ feet for each plug set.  
Filled with mud from total depth 3670' to 122' set wood plug at 122' dumped 10 sacks cement on top of plug, mud to 8' below bottom of cellar dumped 6 sacks cement on top of plug, filled to surface with mud & dirt.

pd.  
12/30/40  
pd.

PLUGGING  
FILE 5 6 1940  
BOOK PAGE 124 LINE 18

01-11-1941  
JAN 11 1941  
STATE OF KANSAS  
CONSERVATION DIV.

(If additional description is necessary, use BACK of this sheet)  
Correspondence regarding this well should be addressed to R. C. Hauber  
Address Cities Service Oil Co. Great Bend, Kansas.

STATE OF Kansas, COUNTY OF Russell, ss.  
J. A. Cleverley (employee of owner) or (operator) of the above-described well,  
being first duly sworn on oath, says: That I have knowledge of the facts, statements and matters herein contained and the log of the above-described well as filed and that the same are true and correct. So help me God.  
(Signature) J. A. Cleverley  
Cities Service Oil Co. Russell, Kansas (Address)

SUBSCRIBED AND SWORN to before me this 6 day of December, 1940.  
R. J. Turner Notary Public.

My commission expires January 26, 1942



15-163-30304-00-00

# CITIES SERVICE OIL COMPANY

PRODUCERS-REFINERS-MARKETERS OF PETROLEUM PRODUCTS

**BARTLESVILLE  
OKLAHOMA**

Great Bend, Kansas  
January 10, 1941

State Corporation Commission  
Conservation Division  
800 Bitting Building  
Wichita, Kansas

Gentlemen:

Attached herewith is Well Plugging Record of the work done in connection with plugging and abandoning our Johnston well No. 1, Section 5-6-19W, Rooks County, Kansas, drilled as a dry hole.

To complete all records, we are also attaching written Well Plugging Application, together with log of the well.

Very truly yours,

CITIES SERVICE OIL COMPANY

R. C. Hauber

EH:  
Attach.

