

CARD MUST BE TYPED

State of Kansas

CARD MUST BE SIGNED

NOTICE OF INTENTION TO DRILL

(see rules on reverse side)

Expected Spud Date... 8/25/87
month day year

API Number 15— 065-22,398-0000

OPERATOR: License # 4767

NW SE SE Sec. 36 Twp. 6 S, Rg. 21 X West

Name Ritchie Exploration, Inc.

990 Ft. from South Line of Section

Address 125 N. Market, Suite 1000

990 Ft. from East Line of Section

City/State/Zip Wichita, KS 67202

(Note: Locate well on Section Plat on reverse side)

Contact Person Jeff Christian

Nearest lease or unit boundary line 330 feet

Phone 316/267-4375

County Graham

CONTRACTOR: License # 6033

Lease Name Don Billips Trust Well #1

Name Murfin Drilling Co.

Ground surface elevation 2200 feet MSL

City/State Wichita, KS

Domestic well within 330 feet: yes X no

Well Drilled For: Well Class: Type Equipment:

Municipal well within one mile: yes X no

X Oil Storage Infield X Mud Rotary

Depth to bottom of fresh water... 100

 Gas Inj Pool Ext. Air Rotary

Depth to bottom of usable water... 1200

 OWWO Expl X Wildcat Cable

Surface pipe by Alternate: 1 2 X

If OWWO: old well info as follows:

Surface pipe planned to be set... 200'

Operator

Conductor pipe required

Well Name

Projected Total Depth... 3750 feet

Comp Date... Old Total Depth.....

Formation... Arbuckle

I certify that well will comply with K.S.A. 55-101, et seq., plus eventually plugging hole to KCC specifications.

Date 8/14/87 Signature of Operator or Agent Jeff Christian Title... Geologist

For KCC Use:

Conductor Pipe Required .. feet; Minimum Surface Pipe Required 200 feet per Alt. X


This Authorization Expires 2-17-88 Approved By John 8-17-87

Must be filed with the K.C.C. five (5) days prior to commencing well
This card void if drilling not started within six (6) months of date received by K.C.C.

Important procedures to follow:

1. Notify District office before setting surface casing.
2. Set surface casing by circulating cement to the top.
3. File completion forms ACO-1 with K.C.C. within 120 days of well spud date, following instructions on ACO-1, side 1, and including copies of wireline logs.
4. Notify District office 48 hours prior to old well workover or re-entry.
5. Prior to filing Intent, prepare a proposed plugging plan in case well is D & A, then obtain approval of plan when calling district office prior to setting surface pipe.
6. Submit plugging report (CP-4) to K.C.C. after plugging is completed.
7. Obtain an approved injection docket number before disposing of salt water.
8. Notify K.C.C. within 10 days when injection commences or terminates.
9. If an alternate 2 completion, cement in the production pipe from below any usable water to surface within 120 days of spud date.

**A Regular Section of Land
1 Mile = 5,280 Ft.**

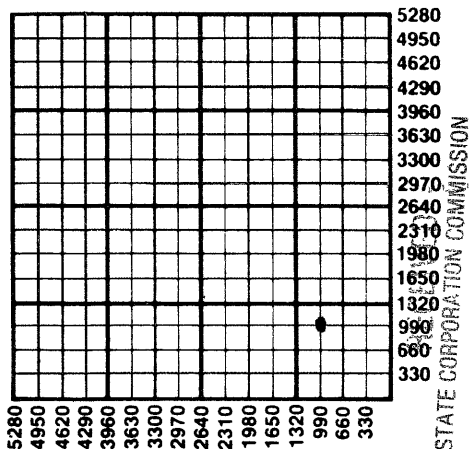

AUG 17 1987

CONSERVATION DIVISION
Wichita, Kansas

S-17-87

State Corporation Commission of Kansas
Conservation Division
200 Colorado Derby Building
Wichita, Kansas 67202-1212
(316) 263-3238