

CARD MUST BE TYPED

State of Kansas

CARD MUST BE SIGNED

NOTICE OF INTENTION TO DRILL

(see rules on reverse side)

Starting Date January 25, 1989
month day year

API Number 15— 065-22,509-00-00 ✓ 10 — East

OPERATOR: License # 6889

NE. SE. SE. Sec. 9... Twp. 6... S, Rg. 22... West

Name Oxford Exploration Company

..... 990..... Ft. from South Line of Section

Address P.O. Box 37390

..... 330..... Ft. from East Line of Section

City/State/Zip Denver, CO 80237

(Note: Locate well on Section Plat on reverse side)

Contact Person David E. Park, Jr.

Nearest lease or unit boundary line 330..... feet

Phone 303-741-2888

County Graham

CONTRACTOR: License # 6033

Lease Name Mary Rush Well # 9-16-1

Name Murfin Drilling

Ground surface elevation ~~to be supplied~~ feet MSL

City/State Wichita, KS

22646L

Well Drilled For: Well Class: Type Equipment:

Domestic well within 330 feet: yes no

Oil SWD Infield Mud Rotary

Municipal well within one mile: yes no

Gas Inj Pool Ext. Air Rotary

Depth to bottom of fresh water 180'

OWWO Expl Wildcat Cable

Depth to bottom of usable water ~~1200~~ 1300

If OWWO: old well info as follows:

Surface pipe by Alternate: 1 2

Operator

Surface pipe planned to be set 200'

Well Name

Conductor pipe required none

Comp Date Old Total Depth

Projected Total Depth 4000

I certify that well will comply with K.S.A. 55-101, et seq., plus eventually plugging hole to KCC specifications.

Date 1/13/89 Signature of Operator or Agent

Barry R. Gager Title Geologist

For KCC Use:

Conductor Pipe Required feet; Minimum Surface Pipe Required 200' feet per Alt. X (2)

This Authorization Expires 7-18-89 Approved By LKM 1-18-89


EFFECTIVE DATE: 1-23-89

Must be filed with the K.C.C. five (5) days prior to commencing well
 This card void if drilling not started within six (6) months of date received by K.C.C.

Important procedures to follow:

1. Notify District office before setting surface casing.
2. Set surface casing by circulating cement to the top.
3. File completion forms ACO-1 with K.C.C. within 90 days of well completion, following instructions on ACO-1, side 1, and including copies of wireline logs.
4. Notify District office 48 hours prior to old well workover or re-entry.
5. Prior to filing Intent, prepare a proposed plugging plan in case well is D & A, then obtain approval of plan when calling district office prior to setting surface pipe.
6. Submit plugging report (CP-4) to K.C.C. after plugging is completed.
7. Obtain an approved injection docket number before disposing of salt water.
8. Notify K.C.C. within 10 days when injection commences or terminates.
9. If an alternate 2 completion, cement in the production pipe from below any usable water to surface within 120 days of spud date.

A Regular Section of Land
1 Mile = 5,280 Ft.

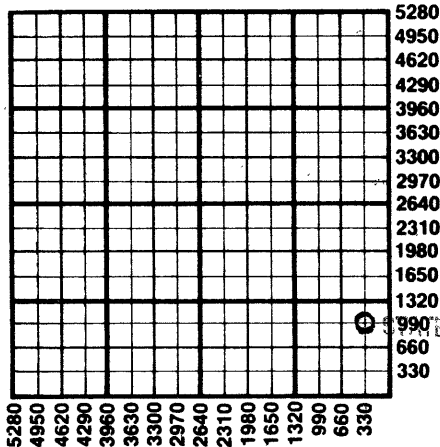

RECEIVED
 STATE CORPORATION COMMISSION

JAN 27 1989

CONSERVATION DIVISION
 Wichita, Kansas

1-17-89

State Corporation Commission of Kansas
 Conservation Division
 200 Colorado Derby Building
 Wichita, Kansas 67202
 (316) 263-3238