

CARD MUST BE TYPED

State of Kansas

CARD MUST BE SIGNED

NOTICE OF INTENTION TO DRILL

(see rules on reverse side)

Starting Date 1/28/86
month day year **853**

API Number 15— **065-22,298-00-00**

OPERATOR: License # 4767
Name Ritchie Exploration, Inc.
Address 125 N. Market, Suite 1000
City/State/Zip Wichita, Kansas 67202
Contact Person Galen Babcock
Phone 316/267-4375

SW NW NE Sec. **13** Twp. **6** S, Rg. **22** East West
4290 Ft. from South Line of Section
2310 Ft. from East Line of Section

(Note: Locate well on Section Plat on reverse side)

CONTRACTOR: License # 6033
Name Murfin Drilling Co.
City/State Wichita, Kansas

Nearest lease or unit boundary line 330 feet
County Graham
Lease Name **Ary** Well # ... **2**

Well Drilled For: Well Class: Type Equipment:
 Oil SWD Infield Mud Rotary
 Gas Inj Pool Ext. Air Rotary
 OWWO Expl Wildcat Cable

Ground surface elevation ... **2285** feet MSL
Domestic well within 330 feet: yes no
Municipal well within one mile: yes no

If OWWO: old well info as follows:
Operator
Well Name
Comp Date Old Total Depth

Depth to bottom of fresh water ~~160~~ **200**
Depth to bottom of usable water **1200**
Surface pipe by Alternate: 1 2

I certify that well will comply with K.S.A. 55-101, et seq., plus eventually plugging hole to KCC specifications.
Date **1/24/86** Signature of Operator or Agent **Galen Babcock** Title **Geologist**

Surface pipe planned to be set **240**
Conductor pipe required
Projected Total Depth **3850** feet
Formation **Arbuckle**

For KCC Use:
Conductor Pipe Required feet; Minimum Surface Pipe Required feet per Alt. **1**
This Authorization Expires **7-27-86** Approved By **1-27-86**

REC/10/86
EO

Must be filed with the K.C.C. five (5) days prior to commencing well
 This card void if drilling not started within six (6) months of date received by K.C.C.

1-27-86

Important procedures to follow:


RECEIVED

STATE CORPORATION COMMISSION

A Regular Section of Land

1 Mile = 5,280 Ft.

JAN 27 1986

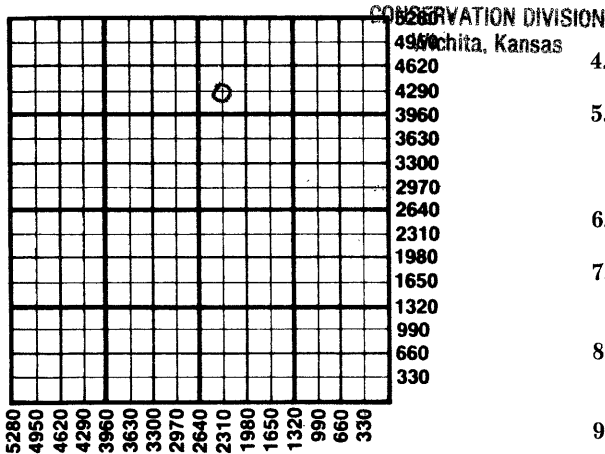

1. Notify District office before setting surface casing.
2. Set surface casing by circulating cement to the top.
3. File completion forms ACO-1 with K.C.C. within 90 days of well completion, following instructions on ACO-1, side 1, and including copies of wireline logs.
4. Notify District office 48 hours prior to old well workover or re-entry.
5. Prior to filing Intent, prepare a proposed plugging plan in case well is D & A, then obtain approval of plan when calling district office prior to setting surface pipe.
6. Submit plugging report (CP-4) to K. C. C. after plugging is completed.
7. Obtain an approved injection docket number before disposing of salt water.
8. Notify K.C.C. within 10 days when injection commences or terminates.
9. If an alternate 2 completion, cement in the production pipe from below any usable water to surface within 120 days of spud date.

State Corporation Commission of Kansas
 Conservation Division
 200 Colorado Derby Building
 Wichita, Kansas 67202
 (316) 263-3238