

Must be approved by the K.C.C. five (5) days prior to commencing well

Expected Spud Date April 7, 1990
month day year

NE SE Sec 9 Twp 6 S, Rg 22 East
West

OPERATOR: License # 6889
Name: Oxford Exploration Company
Address: PO Box 37390
City/State/Zip: Denver, CO 80237
Contact Person: David E. Park, Jr.
Phone: 303-741-2888

1880 feet from South line of Section
660 feet from East line of Section
(Note: Locate well on Section Plat Below)

CONTRACTOR: License #: 6033
Name: Murfin Drilling

County: Graham
Lease Name: Mary Rush Well #: 9-9
Field Name: Springbird

Well Drilled For: Well Class: Type Equipment:
X Oil ... Inj ... Infield X Mud Rotary
... Gas ... Storage X Pool Ext. ... Air Rotary
... OWWO ... Disposal ... Wildcat ... Cable
... Seismic; ... # of Holes

Is this a Prorated Field? ... yes X no
Target Formation(s): Lansing-Kansas City
Nearest lease or unit boundary: 660'
Ground Surface Elevation: to be supplied feet MSL
Domestic well within 330 feet: ... yes X no
Municipal well within one mile: ... yes X no
Depth to bottom of fresh water: 180'
Depth to bottom of usable water: 1300'
Surface Pipe by Alternate: ... 1 X 2
Length of Surface Pipe Planned to be set: 200'
Length of Conductor pipe required: none
Projected Total Depth: 4000'
Formation at Total Depth: Granite
Water Source for Drilling Operations:
... well ... farm pond X other
DWR Permit #: NA
Will Cores Be Taken?: ... yes X no
If yes, proposed zone:

If OWWO: old well information as follows:
Operator:
Well Name:
Comp. Date: Old Total Depth

Directional, Deviated or Horizontal wellbore? ... yes X no
If yes, total depth location:

AFFIDAVIT


The undersigned hereby affirms that the drilling, completion and eventual plugging of this well will comply with K.S.A. 55-101, et. seq.

It is agreed that the following minimum requirements will be met:

1. The appropriate district office shall be notified before setting surface pipe;
2. The minimum amount of surface pipe as specified above shall be set by circulating cement to the top; in all cases surface pipe shall be set through all unconsolidated materials plus a minimum of 20 feet into the underlying formation;
3. If the well is dry, a plugging proposal shall be submitted to the district office. An agreement between the operator and the district office on plug length and placement is necessary prior to plugging;
4. The appropriate district office will be notified before well is either plugged or production casing is cemented in;
5. If an Alternate II completion, production pipe shall be cemented from below any usable water to surface within 120 days of spud date. In all cases, notify district office prior to any cementing.

I hereby certify that the statements made herein are true and to the best of my knowledge and belief.

Date: 3/21/90 Signature of Operator or Agent: Barry R. Gager Title: Geologist

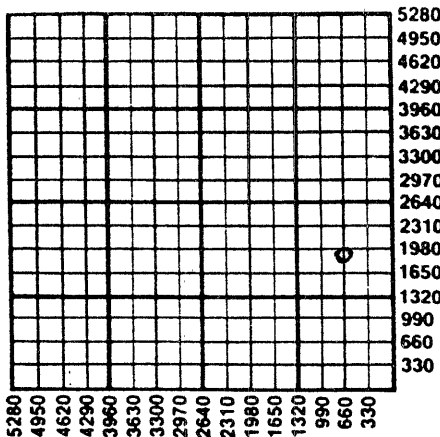

STATE COMMISSION
APPROVED

MAR 23 1990
3-23-90
CONSERVATION DIVISION
Wichita, Kansas

FOR KCC USE:
API # 15- 065-22562 00-00
Conductor pipe required NONE feet
Minimum surface pipe required 300 feet per Alt. X(2)
Approved by: DE 3-26-90
EFFECTIVE DATE: 3-31-90
This authorization expires: 10-1-90
(This authorization void if drilling not started within 6 months of effective date.)
Spud date: Agent:

REMEMBER TO:

- File Drill Pit Application (form CDP-1) with Intent to Drill;
- File Completion Form ACO-1 within 120 days of spud date;
- File acreage attribution plat according to field proration orders;
- Notify appropriate district office 48 hours prior to workover or re-entry;
- Submit plugging report (CP-4) after plugging is completed;
- Obtain written approval before disposing or injecting salt water.