

PLAT AND CERTIFICATION OF ACREAGE ATTRIBUTABLE TO AN OIL WELL

State Corporation Commission, Conservation Division
200 Colorado Derby Bldg. Wichita, Kansas 67202

OPERATOR PanCanadian Petroleum Company

LOCATION OF WELL:

LEASE Pennington

660 feet from the east line

1980 feet from the north line

WELL NUMBER 42-17 #2

Of the NE corner of Sec 17 T. 6S R. 22W

FIELD Penn

COUNTY Graham



*NUMBER OF ACRES
ATTRIBUTABLE TO WELL 40

DESCRIPTION OF ACREAGE:

SE/4 NE/4 Section 17-T6S-R22W

PLAT

(Show location of Well and outline attributable acreage)
(Show footage to nearest lease or unit boundary line)

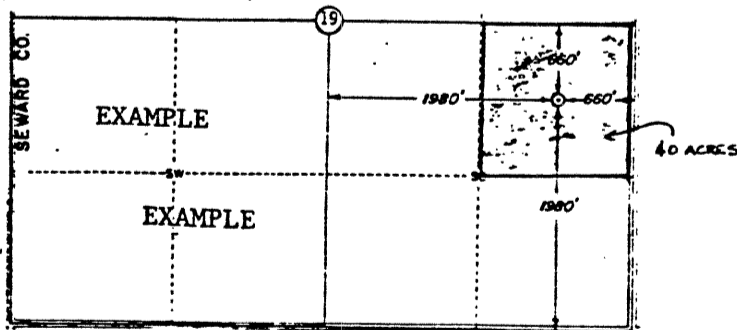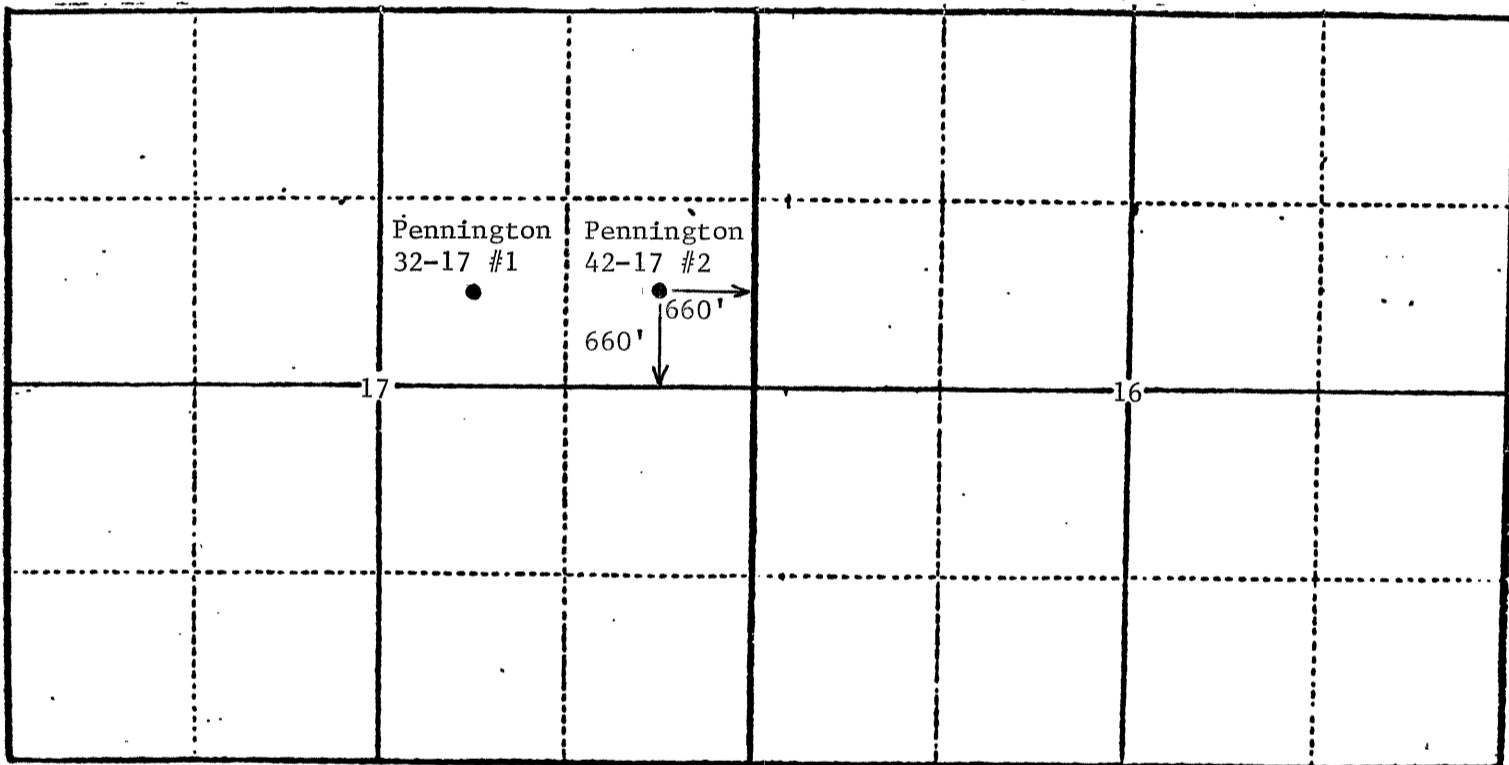

RECEIVED
STATE CORPORATION COMMISSION
APR 28 1986
CONSERVATION DIVISION
Wichita, Kansas
4-28-86

The undersigned hereby certifies that he is Coordinator U.S. Operations
for PanCanadian Petroleum Company, a duly authorized agent, that all information
shown hereon is true and correct to the best of his knowledge and belief, and that
all acreage claimed as attributable to the well named herein is held by production
from that well.

James D. Keisling
James D. Keisling

Suscribed and sworn to before me on this 20th day of April, 1986.

Barbara Wolf
Notary Public

My Commission Expires:
February 29, 1988

My Commission expires _____