


15-068-21639-00-00

STATE OF KANSAS
STATE CORPORATION COMMISSION

WELL PLUGGING RECORD

Give All Information Completely
Make Required Affidavit
Mail or Deliver Report to
Conservation Division
State Corporation Comm.
245 North Water
Wichita, KS 67202

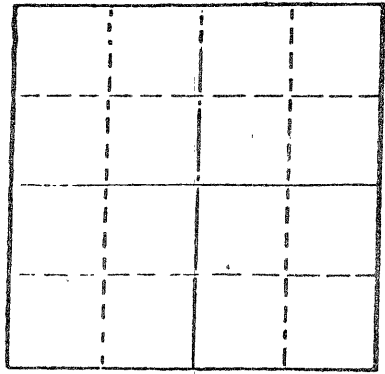

Locate well correctly on above
Section Plot

Graham County. Sec. 7 Twp. 6 Rge. 22WE/W
Location as "NE/CNW $\frac{1}{4}$ SW $\frac{1}{4}$ " or footage from lines
N $\frac{1}{2}$ SE
Lease Owner Ron's Oil Operations
Lease Name Jacobs Well No. 1
Office Address Box 76 Hill City, Kansas 67642
Character of Well (Completed as Oil, Gas or Dry Hole)
dry hole
Date Well completed 7-20-82 19
Application for plugging filed 7-20-82 19
Application for plugging approved 7-20-82 19
Plugging commenced 1:00 A.M. 7-20-82 19
Plugging completed 2:45 A.M. 7-20-82 19
Reason for abandonment of well or producing formation
dry
If a producing well is abandoned, date of last production
19

Was permission obtained from the Conservation Division or
its agents before plugging was commenced? yes
Name of Conservation Agent who supervised plugging of this well Dennis Hamel
Producing formation _____ Depth to top _____ Bottom _____ Total Depth of Well _____
Show depth and thickness of all water, oil and gas formations.

OIL, GAS OR WATER RECORDS

CASING RECORD

FORMATION	CONTENT	FROM	TO	SIZE	PUT IN	PULLED OUT

Describe in detail the manner in which the well was plugged, indicating where the mud fluid
was placed and the method or methods used in introducing it into the hold. If cement or other
plugs were used, state the character of same and depth placed, from _____ feet to
_____ feet for each plug set.

1st plug 1260 with 80 sacks
2nd plug 270 with 40 sacks
3rd plug 40 with 10 sacks
1 sack hulls and plug for solid bridge
10 sacks for rat hole
Total 140 sacks 50/50 poz 4% gel 3% cc


(If additional description is necessary, use BACK of this sheet)

Name of Plugging Contractor Lawbanco Drilling, Inc.
Box 289 Natoma, Kansas 67651

STATE OF Kansas COUNTY OF Osborne, ss.
R. L. Finney (employee of owner) or (owner or operator)

of the above-described well, being first duly sworn on oath, says: That I have knowledge of
the facts, statements, and matters herein contained and the log of the above-described well
as filed and that the same are true and correct. So help me God.

(Signature) R. L. Finney
2220 Marjorie Hays, Kansas 67601
(Address)

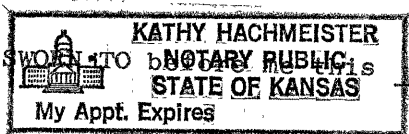

SUBSCRIBED AND SWORN TO 27th day of July, 19 82

Kathy Hachmeister
Notary Public.

My commission expires 4-20-85

RECEIVED
STATE CORPORATION COMMISSION
JUL 28 1982
CONSERVATION DIVISION
Wichita, Kansas