


15-065-02226-00-00

STATE OF KANSAS
STATE CORPORATION COMMISSION

Give All Information Completely
Make Required Affidavit
Mail or Deliver Report to:
Conservation Division
State Corporation Commission
800 Bitting Building
Wichita, Kansas

WELL PLUGGING RECORD

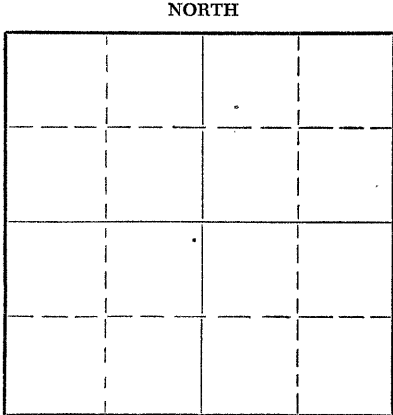

Graham County. Sec. 3 Twp. 6 S Rge. 22 (#) (W)
Location as "NE/CNW/SW" or footage from lines ~~SE SE SE~~ ~~SW SW SW~~
Lease Owner Musgrove Petroleum Corporation, Inc.
Lease Name Richardson Well No. 1
Office Address 407 KFH Building, Wichita 2, Kansas
Character of Well (completed as Oil, Gas or Dry Hole) Dry Hole
Date well completed March 18 1952
Application for plugging filed March 18 1952
Application for plugging approved March 18 1952
Plugging commenced March 18 1952
Plugging completed March 18 1952
Reason for abandonment of well or producing formation Dry

If a producing well is abandoned, date of last production _____ 19____
Was permission obtained from the Conservation Division or its agents before plugging was commenced? Yes

Name of Conservation Agent who supervised plugging of this well _____
Producing formation _____ Depth to top _____ Bottom _____ Total Depth of Well 3735 Feet
Show depth and thickness of all water, oil and gas formations.

OIL, GAS OR WATER RECORDS

CASING RECORD

FORMATION	CONTENT	FROM	TO	SIZE	PUT IN	PULLED OUT
Surface casing				8-5/8"	200'	Cemented

Describe in detail the manner in which the well was plugged, indicating where the mud fluid was placed and the method or methods used in introducing it into the hole. If cement or other plugs were used, state the character of same and depth placed, from _____ feet to _____ feet for each plug set.

Filled hole w/heavy mud.
Set first plug at 190' w/15 sx cement and 1/2 sk hulls.
Set second plug at 40' w/10 sx cement and 1/2 sk hulls.

(If additional description is necessary, use BACK of this sheet)


Name of Plugging Contractor Musgrove Petroleum Corporation, Inc.
Address 407 KFH Building, Wichita 2, Kansas

STATE OF KANSAS, COUNTY OF SEDGWICK, ss.
GORDON L. KOELLING (employee of owner) or (owner or operator) of the above-described well, being first duly sworn on oath, says: That I have knowledge of the facts, statements, and matters herein contained and the log of the above-described well as filed and that the same are true and correct. So help me God.

(Signature) Gordon L. Koelling
407 KFH Building, Wichita 2, Kansas (Address)

SUBSCRIBED AND SWORN to before me this 24th day of April, 19 52

My commission expires July 9, 1952. APR 2 5 1952
Notary Public.

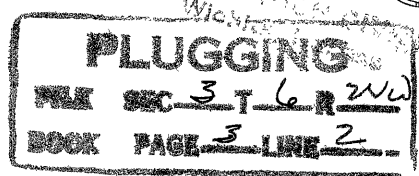

4-25-52