

15-163-22052-00-00

STATE OF KANSAS

STATE CORPORATION COMMISSION

WELL PLUGGING RECORD

Give All Information Completely
Make Required Affidavit
Mail or Deliver Report to
Conservation Division
State Corporation Comm.
200 Colorado Derby Bldg.
202 W. 1st St.
Wichita, KS 67202

Rooks County Sec. 36 Twp. 6s Rge. 20 E/W
Location as "NE/CNW/SW" or footage from lines

2310' FNL 660' FWL

Lease Owner D.A. Hindman

Lease Name Wills Well No. #5

Office Address 405 Main Street Stockton, Kansas 67669

Character of Well (Completed as Oil, Gas or Dry Hole)
Dry Hole

Date Well completed 6-7 1983

Application for plugging filed 6-7 1983

Application for plugging approved 6-7 1983

Plugging commenced 11:00 AM 6-7 1983

Plugging completed 2:30 PM 6-7 1983

Reason for abandonment of well or producing formation
No Commercial Production


If a producing well is abandoned, date of last production
19

Was permission obtained from the Conservation Division or
its agents before plugging was commenced? Yes

Name of Conservation Agent who supervised plugging of this well Marion Schmidt

Producing formation Depth to top Bottom Tl. Depth of Well

Show depth and thickness of all water, oil and gas formations.

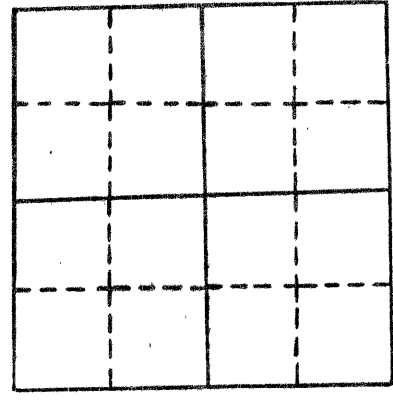

locate well correctly
on above
Section Plot

OIL, GAS OR WATER RECORDS

CASING RECORD

FORMATION	CONTENT	FROM	TO	SIZE	PUT IN	PULLED OUT
Surface Casing	60-40 pos	0'	328'	8 5/8"	328'	0'

Describe in detail the manner in which the well was plugged, indicating where the mud fluid was placed and the method or methods used in introducing it into the hold. If cement or other plugs were used, state the character of same and depth placed, from feet to feet for each plug set.

RECEIVED
STATE CORPORATION COMMISSION

JUN 14 1983
6-14-83

CONSERVATION DIVISION
Wichita, Kansas

Plug #1 3680' with 20 sxs

Plug #2 1734' with 20 sxs

Plug #3 1021' with 90 sxs

Plug #4 378' with 40 sxs

Plug #5 40' with 10 sxs

10 sxs in rathole

TOTAL---- 190 sxs 50-50 pos 4%gel 3%cc

(If additional description is necessary, use BACK of this sheet)

Name of Plugging Contractor Pioneer Drilling Co.
308 W. Mill Plainville, Kansas 67663


STATE OF Kansas COUNTY OF Rooks, ss.

David L. Comeau (employee of owner) or (owner or operator) of the above described well, being first duly sworn on oath, says: That I have knowledge of the facts, statements, and matters herein contained and the log of the above described well is filed and that the same are true and correct. So help me God.

(Signature) [Signature]

(Address) 308 W. Mill Plainville, Ks. 67663

SUBSCRIBED AND SWORN TO before me this 13th day of June, 1983

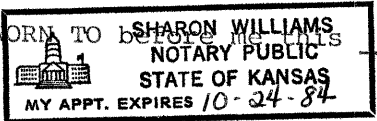

My commission expires

Sharon Williams
Notary Public