


STATE OF KANSAS  
STATE CORPORATION COMMISSION

WELL PLUGGING RECORD

Give All Information Completely  
Make Required Affidavit  
File or Deliver Report to  
Conservation Division  
State Corporation Comm.  
245 North Water  
Wichita, KS 67202

Rooks County, Sec. 36 Twp. 6S Rge. 20 ~~W~~  
Location as "NE/CNW/SW" or footage from lines

NE SE NW  
Lease Owner D. A. Hindman  
Lease Name Wills Well No. #1  
Office Address 405 Main Stockton, Kansas 67669  
Character of Well (Completed as Oil, Gas or Dry Hole)

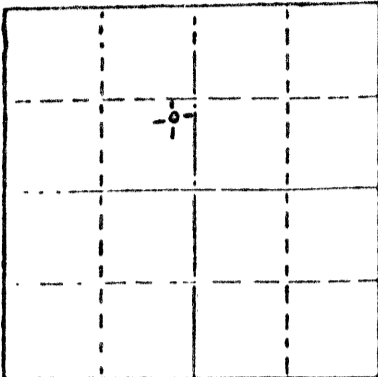

Locate well correctly on above  
Section Plot

D & A  
Date Well completed September 13, 1980 19  
Application for plugging filed September 13, 1980 19  
Application for plugging approved September 13, 1980 19  
Plugging commenced September 13, 1980 19  
Plugging completed September 13, 1980 19  
Reason for abandonment of well or producing formation

No Commercial Production  
If a producing well is abandoned, date of last production 19

Was permission obtained from the Conservation Division or  
its agents before plugging was commenced? Yes  
Name of Conservation Agent who supervised plugging of this well Marion Schmidt

Producing formation \_\_\_\_\_ Depth to top \_\_\_\_\_ Bottom \_\_\_\_\_ Total Depth of Well \_\_\_\_\_  
Show depth and thickness of all water, oil and gas formations.

OIL, GAS OR WATER RECORDS

CASING RECORD

FORMATION	CONTENT	FROM	TO	SIZE	PUT IN	PULLED OUT
surface casing	common	0	238.29	8 5/8	238.29	0

Describe in detail the manner in which the well was plugged, indicating where the mud fluid  
was placed and the method or methods used in introducing it into the hole. If cement or other  
plugs were used, state the character of same and depth placed, from \_\_\_\_\_ feet to  
\_\_\_\_\_ feet for each plug set.

Plug #1 @ 860' with 70 sxs  
Plug #2 @ 210' with 15 sxs  
Plug #3 @ 40' with 10 sxs  
5 sxs in rathole  
cemented with 100 sxs  
50-50 poz 6% gel  
Final Plugdown @ 6:30 p.m.

RECEIVED  
STATE CORPORATION COMMISSION

SEP 29 1980

CONSERVATION DIVISION  
Wichita, Kansas

(If additional description is necessary, use BACK of this sheet)

Name of Plugging Contractor Pioneer Drilling Company, Inc. 308 West Mill  
Plainville, Kansas 67663

STATE OF Kansas COUNTY OF Rooks, ss.  
Liberty Enterprises, Inc. (employee of owner) or (owner or operator)


I, the above-described well, being first duly sworn on oath, says: That I have knowledge of  
the facts, statements, and matters herein contained and the log of the above-described well  
is true and correct. So help me God.

(Signature) *Paul Steiner*  
September 25, 1980  
(Address)

SUBSCRIBED AND SWORN TO before me this 25<sup>th</sup> day of September, 1980

*Connie Jo Austin*  
Notary Public.

My commission expires \_\_\_\_\_

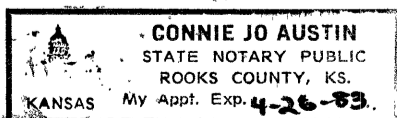

15-163-21142-00-00

WELL LOG

OPERATOR: D. A. Hindman

WELL NAME: Wills LOCATION: NE SE NW 36-6S-20W

COUNTY: Rooks STATE: Kansas

WELL COMMENCED: September 6, 1980 WELL COMPLETED: September 13, 1980

ELEVATION: 2115' D.F. TOTAL DEPTH: 3637'

PRODUCTION: D & A RIG NO: #3

CASING - 8-5/8": 238.29' of new 20# cemented with 115 sxs common 3% cc 2% gel cement-circ.  
5-1/2": \_\_\_\_\_

ALL MEASUREMENTS TAKEN FROM THE TOP OF ROTARY BUSHING:

FROM	TO	FORMATION	DEVIATION FROM VERTICAL	REMARKS:
0'	327'	cement and shale		
327'	1159'	sand and clay	1890' - 1/2 degree	
1159'	1695'	sand and clay	3298' - 1 degree	
1695'	1728'	anhydrite	3529' - 1 degree	
1728'	1753'	sand and shale		
1753'	1890'	shale		
1890'	2000'	shale		
2000'	2235'	shale		
2235'	2455'	shale and lime		
2455'	2693'	shale and lime		
2693'	2850'	shale and lime		
2850'	2994'	shale and lime		
2994'	3113'	shale and lime		
3113'	3205'	lime and shale		
3205'	3298'	lime and shale		
3298'	3298'			
3298'	3357'	lime and shale		
3357'	3435'	lime and shale		
3435'	3520'	lime and shale		
3520'	3529'	lime and shale		
3529'	3592'	lime and shale and chert		
3592'	3622'	lime and shale		
3622'	3637'	lime and shale		
3637'	RTD			

RECEIVED  
STATE CORPORATION COMMISSION

SEP 29 1980

CONSERVATION DIVISION  
Wichita, Kansas

STATE OF KANSAS  
COUNTY OF \_\_\_\_\_

The undersigned hereby certifies that to the best of his knowledge and belief, the above facts are true and correct

PIONEER DRILLING CO., INC.

By Charles J. Conner

SUBSCRIBED AND SWORN TO, BEFORE ME, This 25<sup>th</sup> day of Sept., 1980.

Connie Jo Austin  
NOTARY PUBLIC

