


15-103-00856-00-00

STATE OF KANSAS
STATE CORPORATION COMMISSION

Give All Information Completely
Make Required Affidavit
Mail or Deliver Report to:
Conservation Division
State Corporation Commission
800 Bitting Building
Wichita, Kansas

WELL PLUGGING RECORD

Rooks County, Sec. 36 Twp. 6 Rge. 20 (E) (W)
Location as "NE/CNW%SW%" or footage from lines 330 ft. N. 330 Ft. E.
Lease Owner Sauvage, Betts and Stickelman
Lease Name Vehige Well No. 1
Office Address Oberlin, Kansas
Character of Well (completed as Oil, Gas or Dry Hole) dry hole
Date well completed March 30 1955
Application for plugging filed April 12 1955
Application for plugging approved April 12 1955
Plugging commenced April 12 1955
Plugging completed April 15 1955
Reason for abandonment of well or producing formation dry hole

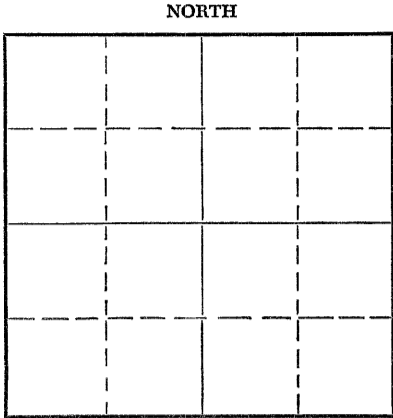

Locate well correctly on above
Section Plat

If a producing well is abandoned, date of last production _____ 19____
Was permission obtained from the Conservation Division or its agents before plugging was commenced? yes

Name of Conservation Agent who supervised plugging of this well Eldon Petty
Producing formation _____ Depth to top _____ Bottom _____ Total Depth of Well 3614 Feet
Show depth and thickness of all water, oil and gas formations.

OIL, GAS OR WATER RECORDS

CASING RECORD

FORMATION	CONTENT	FROM	TO	SIZE	PUT IN	PULLED OUT

Describe in detail the manner in which the well was plugged, indicating where the mud fluid was placed and the method or methods used in introducing it into the hole. If cement or other plugs were used, state the character of same and depth placed, from _____ feet to _____ feet for each plug set.

Filled hole with sand from 3610 ft. to 3575 ft. then filled with mud cement to 3545 ft. filled with heavy mud to 170 ft. set plug filled with rock from 170 ft. to 165 ft. and filled with cement to 125 ft. filled with mud to 40 ft. and rock to 35 ft. set plug and filled to top with cement.

(If additional description is necessary, use BACK of this sheet)

Name of Plugging Contractor J. M. Patterson and Son
Address Arkansas City, Kansas

STATE OF Kansas, COUNTY OF Decatur, ss.

(employee of owner) or (owner or operator) of the above-described well, being first duly sworn on oath, says: That I have knowledge of the facts, statements, and matters herein contained and the log of the above-described well as filed and that the same are true and correct. So help me God.

(Signature) [Signature]
[Signature]
(Address)

SUBSCRIBED AND SWORN TO before me this 21st day of April, 1955

My commission expires May 17, 1955

[Signature]
Notary Public.

PLUGGING
FILE SEC 36 T 6 R 20 W
PAGE 12 LINE 9

24-7368-S 3-53-20M RECEIVED
STATE CORPORATION COMMISSION

APR 21 1955
CONSERVATION DIVISION
Wichita, Kansas
4-29-55

15-163-00856-00-00

Drillers Log

Lease : Vehige
SE SE SE36-6-20
Rooks County

Lease Owner: Sauvage, Betts & Stickleman
Contractor: Sauvage Dunn Drilg. Co., Inc
Rotary Commenced: March 9, 1955
Rotary Completed: March 19, 1955
Casing record: 163 feet of 8 5/8 csg.

*** Figures denote bottom of the hole

Cellar	5
Shale & Shells	995
Shale & Shells	1550
Red bed	1612
Anhydrite	1651
Shale & shells	1715
Shale & Shells	1995
Shale & Shells	2075
Shale & Shells	2170
Shale & Shells	2190
Shale & Lime	2360
Shale & Lime	2560
Shale & Shells	2645
Shale & Lime	2795
Shale & Lime	2910
Shale & Lime	3039
Shale & Lime	3280
Lime & Shale	3370
Lime & Shale	3462
Lime	3500
Lime & Shale	3581
Lime	3596

CERTIFICATE

State of Kansas
County of Decatur

I hereby certify that the foregoing is to the best of my knowledge and belief a full true, correct drilling log as shown by the daily drilling reports in connection with the asforsaid well.

Paul Sauvage
For Sauvage-Dunn Drilling Co., Inc.

Subscribed and sworn before me, the undersigned, a notary public
this 23rd day of April, 1955

Paul Sauvage
My Commission expires May 17, 1955

RECEIVED
4-25-55

PLUGGING
FILE SEC 36-6-R-20W
BOOK PAGE 112 LINE 9