


15-163-20734-00-00

STATE OF KANSAS
STATE CORPORATION COMMISSION

WELL PLUGGING RECORD

Give All Information Completely
Make Required Affidavit
Mail or Deliver Report to
Conservation Division
State Corporation Comm.
245 North Water
Wichita, KS 67202

Rooks County. Sec. 35 Twp. 6S Rge. 20 E/W
Location as "NE/CNW $\frac{1}{4}$ SW $\frac{1}{4}$ " or footage from lines
NE NW SE
Lease Owner K & E Petroleum, Inc.
Lease Name Gartrell "B" Well No. 1
Office Address 816 Union Center, Wichita, Kansas 67202
Character of Well (Completed as Oil, Gas or Dry Hole)
Dry Hole

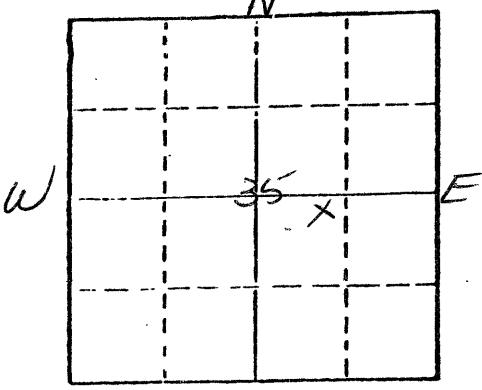

Locate well correctly on above
Section Plot

Date Well completed Sept. 9, 1977
Application for plugging filed (verbally) Sept. 9, 1977
Application for plugging approved (verbally) Sept. 9, 1977
Plugging commenced Sept. 9, 1977
Plugging completed Sept. 9, 1977
Reason for abandonment of well or producing formation
No commercial quantity of oil or gas encountered
If a producing well is abandoned, date of last production
19

Was permission obtained from the Conservation Division or
its agents before plugging was commenced? Yes

Name of Conservation Agent who supervised plugging of this well Leo Massey
Producing formation Depth to top Bottom Total Depth of Well 3681
Show depth and thickness of all water, oil and gas formations.

OIL, GAS OR WATER RECORDS

CASING RECORD

FORMATION	CONTENT	FROM	TO	SIZE	PUT IN	PULLED OUT

Describe in detail the manner in which the well was plugged, indicating where the mud fluid
was placed and the method or methods used in introducing it into the hold. If cement or other
plugs were used, state the character of same and depth placed, from _____ feet to
_____ feet for each plug set.

Set 1st plug at 720' with 70 sacks
2nd plug at 240' with 20 sacks
3rd plug at 40' with 10 sacks
Cemented with 50/50 posmix, 6% gel.

SEP 15 1977 9-15-77

Plug was down at 10:00 p.m., September 9, 1977


(If additional description is necessary, use BACK of this sheet)

Name of Plugging Contractor Abercrombie Drilling, Inc.

STATE OF Kansas COUNTY OF Sedgwick, ss.
Jack L. Partridge, Ass't. Secretary-Treasurer (employee of owner) or (owner or operator)
of the above-described well, being first duly sworn on oath, says: That I have knowledge of
the facts, statements, and matters herein contained and the log of the above-described well
as filed and that the same are true and correct. So help me God.

(Signature) Jack L. Partridge
801 Union Center, Wichita, Kansas 67202
(Address)

SUBSCRIBED AND SWORN TO before me this 12th day of September, 1977

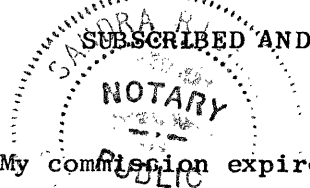

Sandra Richman
Sandra Richman Notary Public.

My commission expires July 21, 1979

OPERATOR: K & E Petroleum, Inc.
 CONTRACTOR: Abercrombie Drilling, Inc.
 WELL NAME: Gartrell "B" #1
 LOCATION: NE NW SE Section 35-6S-20W
 Rooks County, Kansas
 SPUD DATE: September 2, 1977
 COMPLETION DATE: September 9, 1977

0	200	Surface clay & sand
200	246	Shale
246	1285	Shale & sand St.
1285	1485	Sand
1485	1761	Shale
1761	1793	Anhydrite
1739	2570	Shale
2570	3149	Shale & lime
3149	3618	Lime
3618	3670	Lime & conglomerate
3670	3681	Lime
	3681	Rotary Total Depth

Spud hole at 1:00 p.m., September 2, 1977. Drilled 246' of 12 1/4" hole, ran 6 joints 8-5/8" casing, set at 245' KB. Cemented with 190 sacks cement, 3% CaCl, 2% gel. Plug was down at 6:15 p.m., September 2, 1977. Cement did circulate.

T. D. 3681'. Set 1st plug at 720' with 70 sacks, 2nd plug at 240' with 20 sacks and 3rd plug at 40' with 10 sacks. Cemented with 50/50 posmix, 6% gel. Plug was down at 10:00 p.m.,

SAMPLE TOPS:

Anhydrite 1761
 B/Anhydrite 1761

9-15-77
 SEP 15 1977

STATE OF KANSAS
 COUNTY OF SEDGWICK

Jack L. Partridge, Assitant Secretary-Treasurer to Abercrombie Drilling, Inc., does hereby state that the above and foregoing is a true and correct copy of the log of the Gartrell "B" #1, NE NW SE Sec. 35-6S-20W.

ABERCROMBIE DRILLING, INC.
 801 Union Center
 Wichita, Kansas 67202

By Jack L. Partridge

Subscribed and sworn to before me, a Notary Public, in and for the aforesaid county and state as of this 9th day of September.

My commission expires July 21, 1979

Sandra Richman
 Sandra Richman, Notary Public.

