


15-163-20729-00-00

STATE OF KANSAS
STATE CORPORATION COMMISSION

WELL PLUGGING RECORD

Give All Information Completely
Make Required Affidavit
Mail or Deliver Report to
Conservation Division
State Corporation Comm.
245 North Water
Wichita, KS 67202

Rooks County, Sec. 35 Twp. 6 S Rge. 20 ~~NE~~W
Location as "NE/CNW $\frac{1}{4}$ SW $\frac{1}{4}$ " or footage from lines
NE NW SE
Lease Owner K & E Petroleum, Inc.
Lease Name Gartrell "B" Well No. 1
Office Address 816 Union Center, Wichita, Kansas 67202
Character of Well (Completed as Oil, Gas or Dry Hole)
~~Oil~~
Dry Hole

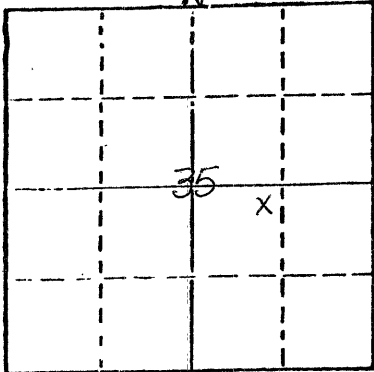

Locate well correctly on above
Section Plat

Date Well completed September 2, 1977
Application for plugging filed (verbally) September 2, 1977
Application for plugging approved (verbally) September 2, 1977
Plugging commenced September 2, 1977
Plugging completed September 2, 1977
Reason for abandonment of well or producing formation
Unable to fish dropped slips out of hole
If a producing well is abandoned, date of last production
19

Was permission obtained from the Conservation Division or
its agents before plugging was commenced? Yes

Name of Conservation Agent who supervised plugging of this well Leo Massey
Producing formation _____ Depth to top _____ Bottom _____ Total Depth of Well 228'
Show depth and thickness of all water, oil and gas formations.

OIL, GAS OR WATER RECORDS

CASING RECORD

| FORMATION | CONTENT | FROM | TO | SIZE | PUT IN | PULLED OUT |
|-----------|---------|------|----|------|--------|------------|
| | | | | | | |
| | | | | | | |
| | | | | | | |
| | | | | | | |
| | | | | | | |

Describe in detail the manner in which the well was plugged, indicating where the mud fluid
was placed and the method or methods used in introducing it into the hold. If cement or other
plugs were used, state the character of same and depth placed, from _____ feet to
_____ feet for each plug set.

Spud at 1:00 p.m., September 1, 1977.
Drilled 228' of 12 $\frac{1}{4}$ " hole. Dropped slips in hole at 5:00 p.m.
Unable to get slips out of hole
Set 1st plug at 215' with 25 sacks
2nd plug at 30' with 20 sacks
Plug was down at 4:00 a.m., September 2, 1977

9-9-77

(If additional description is necessary, use BACK of this sheet)


Name of Plugging Contractor Abercrombie Drilling, Inc.

STATE OF Kansas COUNTY OF Sedgwick, ss.
Jack L. Partridge, Assistant Secretary-Treasurer (employee of owner) or (owner or operator)
of the above-described well, being first duly sworn on oath, says: That I have knowledge of
the facts, statements, and matters herein contained and the log of the above-described well
as filed and that the same are true and correct. So help me God.

(Signature) Jack L. Partridge
801 Union Center, Wichita, Kansas 67202
(Address)

SUBSCRIBED AND SWORN TO before me this 6th day of September, 1977

My Commission expires July 21, 1979
Sandra Richman
Sandra Richman Notary Public.

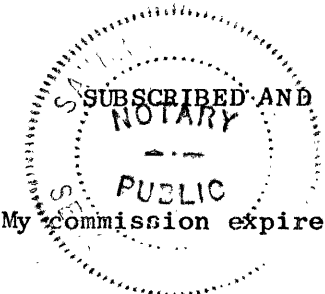

CONTRACTOR'S WELL LOG

| | |
|------------------|--|
| OPERATOR: | K & E Petroleum, Inc. |
| CONTRACTOR: | Abercrombie Drilling, Inc. |
| WELL NAME: | Gartrell "B" #1 |
| LOCATION: | NE NW SE Section 35-6S-20W Rooks County, Kansas |
| SPUD DATE: | September 1, 1977 |
| COMPLETION DATE: | September 2, 1977 |

| | | |
|-----|-----|--------------------|
| 0 | 195 | Sand & clay |
| 195 | 228 | Blue shale |
| | 228 | Rotary Total Depth |

Spud hole at 1:00 p.m., September 1, 1977. Drilled 228' of 12 1/4" hole. Dropped slips in the hole @ 5:00 p.m., fished from 5:00 p.m. to 2:30 a.m. September 2, 1977. Unable to get slips out of hole. Received plugging orders.

Plugged with 25 sacks at 215', 30' solid bridge with 20 sacks. Job complete at 4:00 a.m., September 2, 1977. Cemented with common cement, 3% CaCl, 2% gel.


STATE OF KANSAS)
) ss
COUNTY OF SEDGWICK)

Jack L. Partridge, Assistant Secretary-Treasurer of Abercrombie Drilling, Inc., does hereby state that the above and foregoing is a true and correct copy of the log of the Gartrell "B" #1, NE NW SE Section 35-6S-20W, Rooks County, Kansas.

ABERCROMBIE DRILLING, INC.

By Jack L. Partridge
Jack L. Partridge,
Assistant Secretary-Treasurer

Subscribed and sworn to before me, a Notary Public, in and for the aforesaid county and state as of this 8th day of September, 1977.

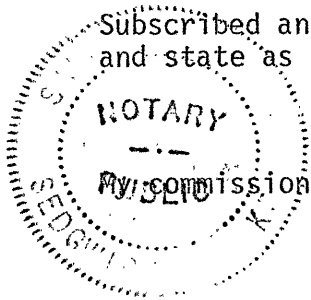

My commission expires July 21, 1979.

Sandra Richman
Sandra Richman, NOTARY PUBLIC

RECORDED
INDEXED
SEP 09 1977
9-9-77