


15-065-00267-00-00

STATE OF KANSAS
STATE CORPORATION COMMISSION

WELL PLUGGING RECORD

Give All Information Completely
Make Required Affidavit
Mail or Deliver Report to:
Conservation Division
State Corporation Commission
800 Bittling Building
Wichita, Kansas

NORTH

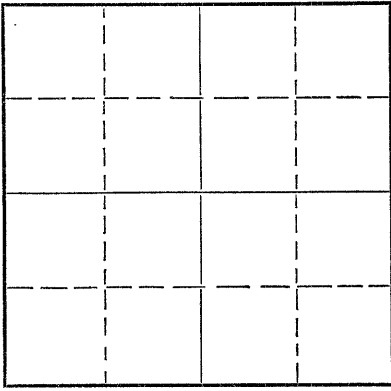

Locate well correctly on above
Section Plat

Graham County. Sec. 19 Twp. 6 Rge. (E) 22 (W)
Location as "NE/CNW $\frac{1}{4}$ /SW $\frac{1}{4}$ " or footage from lines SE SE SW
Lease Owner Herndon Drilling Company
Lease Name ROGERS Well No. 1
Office Address Mayo Building (Drawer 489) Tulsa, Oklahoma
Character of Well (completed as Oil, Gas or Dry Hole) Dry
Date well completed August 20 19 51
Application for plugging filed August 20 19 51
Application for plugging approved August 20 19 51
Plugging commenced August 20 19 51
Plugging completed August 20 19 51
Reason for abandonment of well or producing formation Dry

If a producing well is abandoned, date of last production 19
Was permission obtained from the Conservation Division or its agents before plugging was commenced? Yes

Name of Conservation Agent who supervised plugging of this well Petty
Producing formation _____ Depth to top _____ Bottom _____ Total Depth of Well _____ Feet
Show depth and thickness of all water, oil and gas formations.

OIL, GAS OR WATER RECORDS

CASING RECORD

Formation	Content	From	To	Size	Put In	Pulled Out
		Surface	190'	8-5/8	8-10-51	

Describe in detail the manner in which the well was plugged, indicating where the mud fluid was placed and the method or methods used in introducing it into the hole. If cement or other plugs were used, state the character of same and depth placed, from _____ feet to _____ feet for each plug set.

Filled hole with mud to 180'. Pushed wooden plug to 180' with drill pipe. Mixed 15 sacks cement. Poured cement on top plug. Filled hole to 40'. Pushed plug to 40'. Mixed 10 sacks cement and filled remaining 40' of hole with cement to bottom of cellar 4' below ground level.

STATE CORPORATION COMMISSION
SEP 6 X 1951
9-6-51
CONSERVATION DIVISION
Wichita, Kansas

(If additional description is necessary, use BACK of this sheet)

Name of Plugging Contractor Herndon Drilling Company
Address _____

STATE OF Oklahoma, COUNTY OF Tulsa, ss. _____
(employee of owner) or (owner or operator) of the above-described well,
being first duly sworn on oath, says: That I have knowledge of the facts, statements, and matters herein contained and the log of the above-described well as filed and that the same are true and correct. So help me God.

(Signature) [Signature]
Drawer 489, Tulsa, Oklahoma
(Address)

SUBSCRIBED AND SWORN to before me this 4th day of September 19 51
[Signature] Notary Public.

My commission expires Sept. 19, 1952

23-8390-s 6-51-20M

PLUGGING
FILE SEC 19 T 6 R 22 W
BOOK PAGE 109 LINE 25

15-065-00267-00-00

WELL LOG ON ROGERS #1

Spudding date: 8/8/51
Date casing set: D & A
Date rotary completed: 8/19/51
Date cable completed:

Location:
SE SE SW 19-6-22.
W Graham Co., Kansas

<u>FROM</u>	<u>TO</u>	<u>FORMATION</u>	<u>REMARKS</u>
0	190	Surface	Ran 9 jts. (191.44') of 8-5/8" csg. at 189' w/25 sz Victor and 125 sz bulk cement and 100# C.C.
190	450	Shale	
450	1025	Shale	
1025	1100	Shale & Lime	
1100	1535	Shale & Shells	
1535	1725	Shale & Lime	
1725	2048	Shale & Shells	
2048	2070	Anhydrite	
2070	2280	Shale	
2280	2671	Shale & Shells	
2671	3195	Shale & Lime	
3195	3273	Shale	
3273	3320	Shale & Lime	
3320	3618	Lime	
3618	3645	Lime & Chert	
3645	3682	Lime	
3682	3706	Lime & Chert	
3706	3802	Lime	
3802	3905	Lime	
3905	3945	Shale & Lime	
3945	3997	Lime	
3997		TOTAL DEPTH	Plug at 180' w/15 sz. Plug 40' to Surface w/10 sz.

9-5-51

Subscribed and sworn to before me this 29th day of August, 19 51

I certify the above and foregoing to be a true and exact copy of the original driller's log on the Rogers #1

Eloise Sturgeon
Notary Public
My commission expires:
My commission expires Aug. 28, 1955

HERNDON DRILLING COMPANY
[Signature]
By:
Title:

PLUGGING
FILE SEC 19-6-22
BOOK PAGE 104 LINE 25