

CARD MUST BE TYPED

State of Kansas

CARD MUST BE SIGNED

NOTICE OF INTENTION TO DRILL

(see rules on reverse side)

Starting Date8.....22.....85.....
month day year

API Number 15— 163-22,745-00-00

OPERATOR: License #7076.....
NameBlack Diamond Oil.....
Address1105 E. 30th, Ste. A.....
City/State/ZipHays, KS.....66071.....
Contact Person.....Ken Vehige.....
Phone.....316 -625-5891.....

— East
SE.. .SE.. .NE Sec...33 Twp...6... S, Rg...20.. West
.....2970..... Ft. from South Line of Section
.....330..... Ft. from East Line of Section

(Note: Locate well on Section Plat on reverse side)

CONTRACTOR: License #8241.....
NameEmphasis Oil Operations.....
City/State.....Box 506, Russell, KS.....67665

Nearest lease or unit boundary line330..... feet

County.....Rooks.....

Lease Name.....McMahan..... Well #.....2.....

Ground surface elevationn.a..... feet MSL

Well Drilled For: Well Class: Type Equipment:
 Oil SWD Infield Mud Rotary
 Gas Inj Pool Ext. Air Rotary
 OWWO Expl Wildcat Cable

Domestic well within 330 feet: yes no

Municipal well within one mile: yes no

Surface pipe by Alternate: 1 2

Depth to bottom of fresh water.....100.....

Depth to bottom of usable water ².....1125.....

Surface pipe planned to be set.....200.....

Projected Total Depth3750..... feet

Formation.....Arbuckle.....

If OWWO: old well info as follows:

Operator

Well Name

Comp Date..... Old Total Depth.....

I certify that well will comply with K.S.A. 55-101, et seq., plus eventually plugging hole to KCC specifications.

XX cementing will be done immediately upon setting production casing

Date8./15./85... Signature of Operator or Agent Susan Arnold..... Title...As. Agent.....

REA SOKOHE

For KCC Use:

Conductor Pipe Required feet; Minimum Surface Pipe Required feet per A 1 2

This Authorization Expires..... 8-15-86..... Approved By.....

Must be filed with the K.C.C. five (5) days prior to commencing well
 This card void if drilling not started within six (6) months of date received by K.C.C.

8-19-85


Important procedures to follow:

RECEIVED

A Regular Section of Land
 1 Mile = 5,280 Ft.

STATE CORPORATION COMMISSION

AUG 15 1985

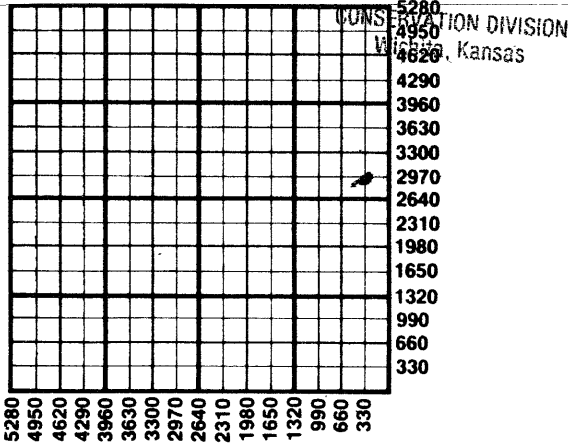

1. Notify District office before setting surface casing.
2. Set surface casing by circulating cement to the top.
3. File completion forms ACO-1 with K.C.C. within 90 days of well completion, following instructions on ACO-1, side 1, and including copies of wireline logs.
4. Notify District office 48 hours prior to old well workover or re-entry.
5. Prior to filing Intent, prepare a proposed plugging plan in case well is D & A, then obtain approval of plan when calling district office prior to setting surface pipe.
6. Submit plugging report (CP-4) to K. C. C. after plugging is completed.
7. Obtain an approved injection docket number before disposing of salt water.
8. Notify K.C.C. within 10 days when injection commences or terminates.
9. If an alternate 2 completion, cement in the production pipe from below any usable water to surface within 120 days of spud date.

State Corporation Commission of Kansas
 Conservation Division
 200 Colorado Derby Building
 Wichita, Kansas 67202
 (316) 263-3238