

CARD MUST BE TYPED

State of Kansas
NOTICE OF INTENTION TO DRILL
(see rules on reverse side)

CARD MUST BE SIGNED

Starting Date: 02 15 86
month day year

API Number 15- 065-22, 303-00-00

OPERATOR: License # 8000
Name PanCanadian Petroleum
Address Box 929
City/State/Zip Denver, CO 80202
Contact Person Tom Rubis
Phone 316-793-5877

NE NW Sec 20 Twp 6 S, Rge 22 East
(location) 4620 West
3300 Ft North from Southeast Corner of Section
Ft West from Southeast Corner of Section
(Note: Locate well on Section Plat on reverse side)

CONTRACTOR: License # 6033
Name Murfin Drilling Company
City/State Wichita, KS 67202

Nearest lease or unit boundary line 660 feet.
County Graham
Lease Name White A1-20 Well# 2-2

Well Drilled For: Well Class: Type Equipment:
 Oil Swd Infield Mud Rotary
 Gas Inj Pool Ext. Air Rotary
 OWWO Expl Wildcat Cable

Domestic well within 330 feet: yes no
Municipal well within one mile: yes no

If OWWO: old well info as follows:
Operator
Well Name
Comp Date Old Total Depth
Projected Total Depth 4000 feet
Projected Formation at TD Arb.
Expected Producing Formations LKC-Arb.

Depth to Bottom of fresh water 200 feet
Lowest usable water formation Dakota
Depth to Bottom of usable water 1225 feet
Surface pipe by Alternate: 1 2
Surface pipe to be set 280 feet
Conductor pipe if any required N/A feet
Ground surface elevation 2392 feet MSL
This Authorization Expires 8-14-86
Approved By [Signature]

I certify that we will comply with K.S.A. 55-101, et seq., plus eventually plugging hole to K.C.C. specifications.


Date 2-14-86
Signature of Operator or Agent [Signature]

[Signature] Title Ass't. Drlg.- Mgr.
Rob Ramseyer, Agent for Operator

**Must be filed with the K.C.C. five (5) days prior to commencing well
This card void if drilling not started within six (6) months of date received by K.C.C.**

Important procedures to follow :

**A Regular Section of Land
1 Mile = 5,280 Ft.**

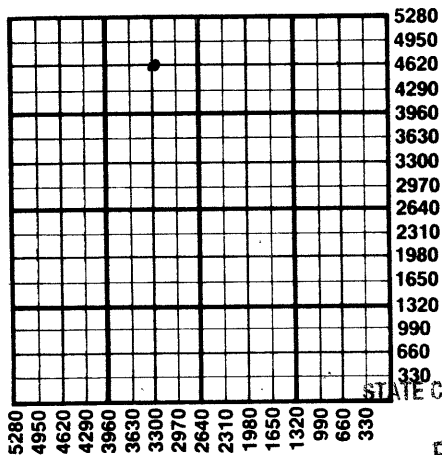

1. Notify District office before setting surface casing.
2. Set surface casing by circulating cement to the top.
3. File completion forms ACO-1 with K.C.C. within 90 days of well completion, following instructions on ACO-1, side 1, and including copies of wireline logs.
4. Notify District office 48 hours prior to old well workover or re-entry.
5. Prior to plugging, prepare a plugging plan, then obtain agreement from the appropriate district office for an approved plugging plan.
6. Submit plugging report (CP-4) to K.C.C. after plugging is completed.
7. Obtain an approved injection docket number before disposing of salt water.
8. Notify K.C.C. within 10 days when injection commences or terminates.

RECEIVED an alternate 2 completion, cement in the production pipe from below
STATE CORPORATION COMMISSION water to surface within 120 days of spud date.

FEB 14 1986
2-14-86
CONSERVATION DIVISION
Wichita, Kansas

**State Corporation Commission of Kansas
Conservation Division
200 Colorado Derby Building
Wichita, Kansas 67202
(316) 263-3238**