

CARD MUST BE TYPED

State of Kansas

CARD MUST BE SIGNED

NOTICE OF INTENTION TO DRILL

(see rules on reverse side)

Starting Date 10 - 5 - 88
month day year

API Number 15-065-22,492-00-00 ✓ DA

OPERATOR: License # 5058
Name Griggs Oil, Inc.
Address 107 N. Market - Ste. 800
City/State/Zip Wichita, KS 67202
Contact Person Rick Griggs
Phone (316) 267-7779

NE SE NW Sec. 25 Twp. 6 S, Rg. 22 — East
..... 3630 Ft. from South Line of Section
..... 2970 Ft. from East Line of Section

(Note: Locate well on Section Plat on reverse side)

CONTRACTOR: License # 9087
Name R & C Drilling
City/State Hays, Kansas

Nearest lease or unit boundary line 990 feet
County Graham

Lease Name Worcester Well # 1

Ground surface elevation 2299 feet MSL

Well Drilled For: Well Class: Type Equipment:
 Oil SWD Infield Mud Rotary
 Gas Inj Pool Ext. Air Rotary
 OWWO Expl Wildcat Cable

Domestic well within 330 feet: yes no

Municipal well within one mile: yes no

Depth to bottom of fresh water 150'

Depth to bottom of usable water 1250'

Surface pipe by Alternate: 1 2

If OWWO: old well info as follows:
Operator
Well Name
Comp Date Old Total Depth

Surface pipe planned to be set 200'

Conductor pipe required

Projected Total Depth 3900 feet

Formation Arbuckle

I certify that well will comply with K.S.A. 55-101, et seq., plus eventually plugging hole to KCC specifications.

Date ... 9/27/88 Signature of Operator or Agent Title Geologist

For KCC Use:

Conductor Pipe Required feet; Minimum Surface Pipe Required 200' feet per Alt. x (2)

This Authorization Expires 3-30-89 Approved By LKM 9-30-88


EFFECTIVE DATE: 10-5-88

Must be filed with the K.C.C. five (5) days prior to commencing well
 This card void if drilling not started within six (6) months of date received by K.C.C.

Important procedures to follow:

1. Notify District office before setting surface casing.
2. Set surface casing by circulating cement to the top.
3. File completion forms ACO-1 with K.C.C. within 90 days of well completion, following instructions on ACO-1, side 1, and including copies of wireline logs.
4. Notify District office 48 hours prior to old well workover or re-entry.
5. Prior to filing Intent, prepare a proposed plugging plan in case well is D & A, then obtain approval of plan when calling district office prior to setting surface pipe.
6. Submit plugging report (CP-4) to K.C.C. after plugging is completed.
7. Obtain an approved injection docket number before disposing of salt water.
8. Notify K.C.C. within 10 days when injection commences or terminates.

A Regular Section of Land
1 Mile = 5,280 Ft.

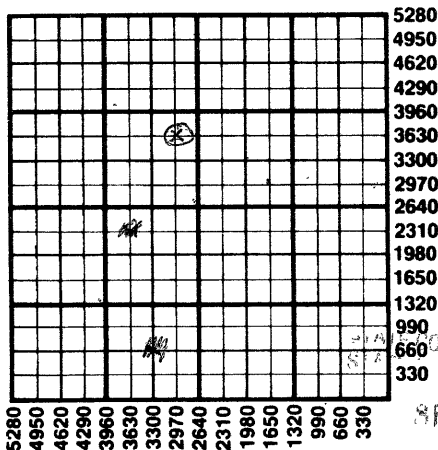

RECEIVED
 STATE CORPORATION COMMISSION

SEP 5 0 1988

CONSERVATION DIVISION
 Wichita, Kansas

9-30-88

If an alternate 2 completion, cement in the production pipe from below any usable water to surface within 120 days of spud date.

State Corporation Commission of Kansas
 Conservation Division
 200 Colorado Derby Building
 Wichita, Kansas 67202
 (316) 263-3238