

CARD MUST BE TYPED

State of Kansas

CARD MUST BE SIGNED

### NOTICE OF INTENTION TO DRILL

(see rules on reverse side)

**\*CORRECTION\***

Expected Spud Date.....5/31/88.....  
month day year

API Number 15-065-22,445-0000  
~~5047 N of~~ <sup>2nd correction</sup> 5-20-88

OPERATOR: License #.....4.767.....

\*\*NW SW SW Sec. 36 Twp. 6 S, Rg. 22 XX East

Name ..Ritchie Exploration, Inc.....

\*\* 990' 1040' ..... Ft. from South Line of Section

Address ..125 N. Market, Suite 1000.....

4950' ..... Ft. from East Line of Section

City/State/Zip ...Wichita, KS...67202.....

(Note: Locate well on Section Plat on reverse side)

Contact Person.....Jeff Christian.....

Nearest lease or unit boundary line .....330..... feet

Phone.....316/267-4375.....

County.....Graham.....

CONTRACTOR: License #.....6.033.....

Lease Name..Thurlow Estate Well #..1.....

Name ..Murfin Drilling Co.....

Ground surface elevation ..est. 2287..... feet MSL

City/State....Wichita, KS.....

Domestic well within 330 feet: \_\_\_\_\_ yes Xno

Well Drilled For: Well Class: Type Equipment:

Municipal well within one mile: \_\_\_\_\_ yes Xno

XXOil \_\_\_\_\_ Storage \_\_\_\_\_ Infield X Mud Rotary

Depth to bottom of fresh water.....100.....

\_\_\_\_\_ Gas \_\_\_\_\_ Inj \_\_\_\_\_ Pool Ext. \_\_\_\_\_ Air Rotary

Depth to bottom of usable water .....1250.....

\_\_\_\_\_ OWWO \_\_\_\_\_ Expl X Wildcat \_\_\_\_\_ Cable

Surface pipe by Alternate: \_\_\_\_\_ 1 2X\_\_\_\_\_

If OWWO: old well info as follows:

Surface pipe planned to be set .....200.....

Operator .....

Conductor pipe required .....

Well Name .....

Projected Total Depth .....3900..... feet

Comp Date ..... Old Total Depth.....

Formation.....Arbuckle.....

I certify that well will comply with K.S.A. 55-101, et seq., plus eventually plugging hole to KCC specifications.

Date ...5/03/88... Signature of Operator or Agent Jeff Christian Title...Geologist.....

For KCC Use: Conductor Pipe Required .....feet; Minimum Surface Pipe Required .....feet per Alt. 200 feet per Alt. \* (2)

This Authorization Expires 9-18-88 ..... Approved By RCA 5-4-88 DRIB. RCV'D 3-18-88 .....

**\*WAS: SW-NW-SW 16SD' FSL** \*\* LOCATION CORRECTION


WAS: ON 5/10/87 API # 15-065-22,445

Must be filed with the K.C.C. five (5) days prior to commencing well  
 This card void if drilling not started within six (6) months of date received by K.C.C.

**Important procedures to follow:**

1. Notify District office before setting surface casing.
2. Set surface casing by circulating cement to the top.
3. File completion forms ACO-1 with K.C.C. within 120 days of well spud date, following instructions on ACO-1, side 1, and including copies of wireline logs.
4. Notify District office 48 hours prior to old well workover or re-entry.
5. Prior to filing Intent, prepare a proposed plugging plan in case well is D & A, then obtain approval of plan when calling district office prior to setting surface pipe.
6. Submit plugging report (CP-4) to K.C.C. after plugging is completed.
7. Obtain an approved injection docket number before disposing of salt water.

**A Regular Section of Land**  
**1 Mile = 5,280 Ft.**

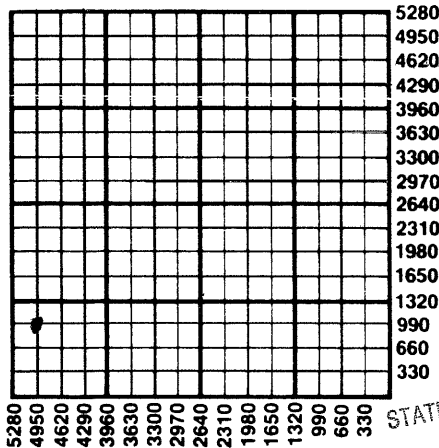

RECEIVED  
 STATE CORPORATION COMMISSION

- Notify K.C.C. within 10 days when injection commences or terminates.
9. If an alternate 2 completion, cement in the production pipe from below any usable water to surface within 120 days of spud date.

MAY 04 1988  
 5-4-88  
 CONSERVATION DIVISION  
 Wichita, Kansas

State Corporation Commission of Kansas  
 Conservation Division  
 200 Colorado Derby Building  
 Wichita, Kansas 67202-1212  
 (316) 263-3238