

CARD MUST BE TYPED

State of Kansas
NOTICE OF INTENTION TO DRILL

CARD MUST BE SIGNED

(see rules on reverse side)

Starting Date: September 1 1984
month day year

API Number 15- 065-22,052-00-00

OPERATOR: License # 6278
Name PETX Petroleum Corporation
Address 1616 Glenarm Place #1700
City/State/Zip Denver, CO 80202
Contact Person Robert E. Johnson
Phone (303) 629-1098

.NENESE. . . . Sec . 34 Twp . 6. S, Rge 22.
(location) 2310
330
□ East
 West
Ft North from Southeast Corner of Section
Ft West from Southeast Corner of Section
(Note: Locate well on Section Plat on reverse side)

CONTRACTOR: License # 5107 6033
Name H-30, Inc. *Mud wells*
City/State Wichita, Kansas

Nearest lease or unit boundary line feet.
County Graham
Lease Name Worcester Well# 1

Well Drilled For: Well Class: Type Equipment:
 Oil Swd Infield Mud Rotary
 Gas Inj Pool Ext. Air Rotary
 OWWO Expl Wildcat Cable

Domestic well within 330 feet: yes no
Municipal well within one mile: yes no

Depth to Bottom of fresh water ~~500~~ feet
Lowest usable water formation Dakota
Depth to Bottom of usable water 600 1/25 feet
Surface pipe by Alternate: 1 2
Surface pipe to be set 300 feet
Conductor pipe if any required feet
Ground surface elevation 2242 feet MSL
This Authorization Expires 2-23-85
Approved By 8-23-84 *R.A. Hauck*

If OWWO: old well info as follows:

Operator
Well Name
Comp Date Old Total Depth
Projected Total Depth 4000 feet
Projected Formation at TD Arbuckle
Expected Producing Formations Arbuckle, Lansing.

I certify that we will comply with K.S.A. 55-101, et seq., plus eventually plugging hole to K.C.C. specifications.

Date 8/20/84 Signature of Operator or Agent *R.A. Hauck* Title Vice President/Exploration


Form C-1 4/84

MHC/KOHE 8/23/84

**Must be filed with the K.C.C. five (5) days prior to commencing well
This card void if drilling not started within six (6) months of date received by K.C.C.**

Important procedures to follow :

**A Regular Section of Land
1 Mile = 5,280 Ft.**

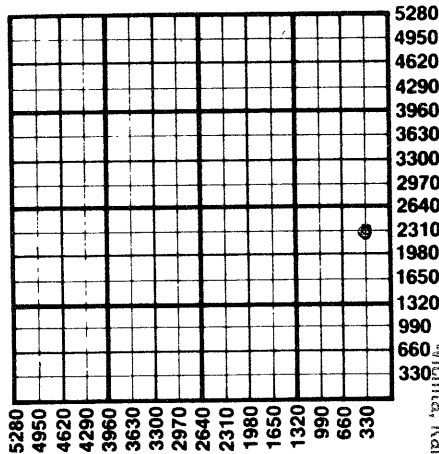

CONSERVATION DIVISION
Wichita, Kansas

AUG 23 1984

RECEIVED
CORPORATION COMMISSION

1. Notify District office before setting surface casing.
2. Set surface casing by circulating cement to the top.
3. File completion forms ACO-1 with K.C.C. within 90 days of well completion, following instructions on ACO-1, side 1, and including copies of wireline logs.
4. Notify District office 48 hours prior to old well workover or re-entry.
5. Prior to plugging, prepare a plugging plan, then obtain agreement from the appropriate district office for an approved plugging plan.
6. Submit plugging report (CP-4) to K.C.C. after plugging is completed.
7. Obtain an approved injection docket number before disposing of salt water.
8. Notify K.C.C. within 10 days when injection commences or terminates.
9. If an alternate 2 completion, cement in the production pipe from below any usable water to surface within 120 days of spud date.

**State Corporation Commission of Kansas
Conservation Division
200 Colorado Derby Building
Wichita, Kansas 67202
(316) 263-3238**

8-23-84