

CARD MUST BE TYPED

State of Kansas

CARD MUST BE SIGNED

NOTICE OF INTENTION TO DRILL

(see rules on reverse side)

Starting Date November 24 1986
month day year

API Number 15— 065-22,340-00-00

OPERATOR: License # 5205
Name Mid-Continent Energy Corp.
Address 120 S. Market Ste 518
City/State/Zip Wichita Kansas 67202
Contact Person Bradley R. Buehler
Phone 316-265-9501

NW. SE. SE. Sec. 32... Twp. 6... S, Rg. 22... X West
990 Ft. from South Line of Section
990 Ft. from East Line of Section

(Note: Locate well on Section Plat on reverse side)

CONTRACTOR: License # 5418
Name Allen Drilling Co.
City/State Great Bend Kansas

Nearest lease or unit boundary line 990 feet
County Graham
Lease Name Scranton Well # 1
Ground surface elevation Est. 2270 feet MSL

Well Drilled For: Well Class: Type Equipment:
X Oil SWD Infield X Mud Rotary
Gas Inj Pool Ext. Air Rotary
OWWO Expl X Wildcat Cable

Domestic well within 330 feet: yes X no
Municipal well within one mile: yes X no
Surface pipe by Alternate: 2X
Depth to bottom of fresh water 80-180
Depth to bottom of usable water 1200
Surface pipe planned to be set 200
Projected Total Depth 3950 feet
Formation Arbuckle

If OWWO: old well info as follows:
Operator
Well Name
Comp Date Old Total Depth

I certify that well will comply with K.S.A. 55-101, et seq., plus eventually plugging hole to KCC specifications.

_____ cementing will be done immediately upon setting production casing.
Date 11-14-86 Signature of Operator or Agent *Robert P. Roberts* Title: Geologist *Rob/KK*


For KCC Use:
Conductor Pipe Required feet; Minimum Surface Pipe Required feet per Alt. *200*
This Authorization Expires 5-14-87 Approved By 11-14-86 *RP*

Must be filed with the K.C.C. five (5) days prior to commencing well
 This card void if drilling not started within six (6) months of date received by K.C.C.

Important procedures to follow:

1. Notify District office before setting surface casing.
2. Set surface casing by circulating cement to the top.
3. File completion forms ACO-1 with K.C.C. within 90 days of well completion, following instructions on ACO-1, side 1, and including copies of wireline logs.
4. Notify District office 48 hours prior to old well workover or re-entry.
5. Prior to filing Intent, prepare a proposed plugging plan in case well is D & A, then obtain approval of plan when calling district office prior to setting surface pipe.
6. Submit plugging report (CP-4) to K.C.C. after plugging is completed.
7. Obtain an approved injection docket number before disposing of salt water.
8. Notify K.C.C. within 10 days when injection commences or terminates.

A Regular Section of Land
 1 Mile = 5,280 Ft.

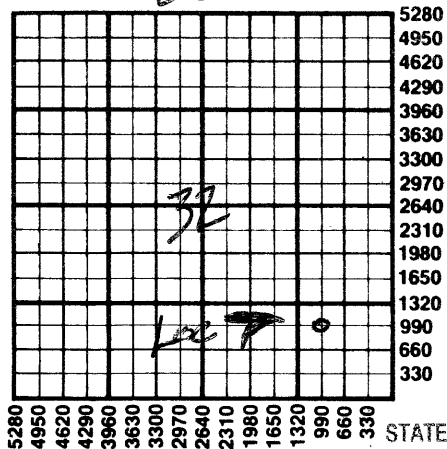

RECEIVED

STATE CORPORATION COMMISSION

Alternate 2 completion, cement in the production pipe from below any usable water to surface within 120 days of spud date.

NOV 14 1986

11-14-86

CONSERVATION DIVISION
 Wichita, Kansas

State Corporation Commission of Kansas
 Conservation Division
 200 Colorado Derby Building
 Wichita, Kansas 67202
 (316) 263-3238