

CARD MUST BE TYPED

State of Kansas
NOTICE OF INTENTION TO DRILL
(see rules on reverse side)

CORRECTION
CARD MUST BE SIGNED
12-6-85

Starting Date: November 1, 1984
month day year

API Number 15-065-22,093-00-00

OPERATOR: License # 5342
Name Beacon Exploration Company
Address 410 17th St., Suite 2300
City/State/Zip Denver, Colorado 80202
Contact Person David Kranz
Phone (303) 825-1966

C/NW SW . . . Sec 30 . Twp 6 . S, Rge 22. East
(location) West

1980 Ft North from Southeast Corner of Section
4620 Ft West from Southeast Corner of Section
(Note: Locate well on Section Plat on reverse side)

CONTRACTOR: License # 6033
Name Murfin Drilling Company
City/State Wichita, Kansas

Nearest lease or unit boundary line 660 feet.
County Graham
Lease Name Fountain Well# 2-30

Well Drilled For: **Well Class:** **Type Equipment:**
 Oil Swd Infield Mud Rotary
 Gas Inj Pool Ext. Air Rotary
 OWWO Expl Wildcat Cable

Domestic well within 330 feet : yes no
Municipal well within one mile : yes no

Depth to Bottom of fresh water 200 feet
Lowest usable water formation Dakota
Depth to Bottom of usable water 1200 feet
Surface pipe by Alternate : 1 2

* Surface pipe to be set 218 feet
Conductor pipe if any required N/A feet
Ground surface elevation 2320 feet MSL
This Authorization Expires 4-22-85
Approved By 10-22-84

If OWWO: old well info as follows:

Operator
Well Name
Comp Date Old Total Depth
Projected Total Depth 3825 feet
Projected Formation at TD Lansing
Expected Producing Formations Lansing

I certify that we will comply with K.S.A. 55-101, et seq., plus eventually plugging hole to K.C.C. specifications. *was 250' surf*


Date Rev. 12/3/84 Signature of Operator or Agent

David Kranz

Title Drlg/Prod Engineer

**Must be filed with the K.C.C. five (5) days prior to commencing well
This card void if drilling not started within six (6) months of date received by K.C.C.**

**A Regular Section of Land
1 Mile = 5,280 Ft.**

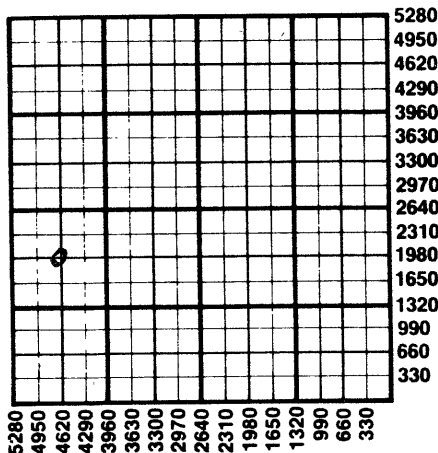

Important procedures to follow:

1. Notify District office before setting surface casing.
2. Set surface casing by circulating cement to the top.
3. File completion forms ACO-1 with K.C.C. within 90 days of completion, following instructions on ACO-1, side 1, and including copies of wireline logs.
4. Notify District office 48 hours prior to old well workover or re-entry.
5. Prior to plugging, prepare a plugging plan, then obtain agreement from the appropriate district office for an approved plugging plan.
6. Submit plugging report (CP-4) to K.C.C. after plugging is completed.
7. Obtain an approved injection docket number before disposing of salt water.
8. Notify K.C.C. within 10 days when injection commences or terminates.
9. If an alternate 2 completion, cement in the production pipe from below any usable water to surface within 120 days of spud date.

RECEIVED
STATE CORPORATION COMMISSION
12-5-84
DEC 05 1984
CONSERVATION DIVISION
Wichita, Kansas

**State Corporation Commission of Kansas
Conservation Division
200 Colorado Derby Building
Wichita, Kansas 67202
(316) 263-3238**