

CARD MUST BE TYPED

State of Kansas

CARD MUST BE SIGNED

### NOTICE OF INTENTION TO DRILL

(see rules on reverse side)

Expected Spud Date. 4/22/88  
month day year

API Number 15- 065-22,452-00-00 ✓  
150' S of  
C SE SE Sec. 13 Twp. 6 S, Rg. 23 X East  
510 West  
660 Ft. from South Line of Section  
660 Ft. from East Line of Section

OPERATOR: License # 4767  
Name Ritchie Exploration, Inc.  
Address 125 N. Market, Suite 1000  
City/State/Zip Wichita, KS 67202  
Contact Person Jeff Christian  
Phone 316/267-4375

(Note: Locate well on Section Plat on reverse side)  
Nearest lease or unit boundary line 510 feet  
County Graham  
Lease Name F&M Bank Well # 1

CONTRACTOR: License # 6033  
Name Murfin Drilling Co.  
City/State Wichita, KS

Ground surface elevation 2346 feet MSL  
Domestic well within 330 feet: \_\_\_yes Xno  
Municipal well within one mile: \_\_\_yes Xno  
Depth to bottom of fresh water 1250 feet  
Depth to bottom of usable water 150 feet  
Surface pipe by Alternate: 1 \_\_\_ 2 X

Well Drilled For: Well Class: Type Equipment:  
X Oil \_\_\_ Storage \_\_\_ Infield X Mud Rotary  
\_\_\_ Gas \_\_\_ Inj \_\_\_ Pool Ext. \_\_\_ Air Rotary  
\_\_\_ OWWO \_\_\_ Expl X Wildcat \_\_\_ Cable

Surface pipe planned to be set 240 feet  
Conductor pipe required  
Projected Total Depth 3975 feet  
Formation Arbuckle

If OWWO: old well info as follows:

Operator  
Well Name  
Comp Date Old Total Depth

I certify that well will comply with K.S.A. 55-101, et seq., plus eventually plugging hole to KCC specifications.

Date 4/15/88 Signature of Operator or Agent Jeff Christian Title Geologist

For KCC Use:

Conductor Pipe Required \_\_\_ feet; Minimum Surface Pipe Required 200 feet per Alt. X (2)

This Authorization Expires 10-18-88 Approved By JCH 4-18-88


EFFECTIVE DATE: 4-23-88

Must be filed with the K.C.C. five (5) days prior to commencing well  
 This card void if drilling not started within six (6) months of date received by K.C.C.

**Important procedures to follow:**

1. Notify District office before setting surface casing.
2. Set surface casing by circulating cement to the top.
3. File completion forms ACO-1 with K.C.C. within 120 days of well spud date, following instructions on ACO-1, side 1, and including copies of wireline logs.
4. Notify District office 48 hours prior to old well workover or re-entry.
5. Prior to filing Intent, prepare a proposed plugging plan in case well is D & A, then obtain approval of plan when calling district office prior to setting surface pipe.
6. Submit plugging report (CP-4) to K.C.C. after plugging is completed.
7. Obtain an approved injection docket number before disposing of salt water.
8. Notify K.C.C. within 10 days when injection commences or terminates.
9. If an alternate 2 completion, cement in the production pipe from below any usable water to surface within 120 days of spud date.

**A Regular Section of Land**  
 1 Mile = 5,280 Ft.

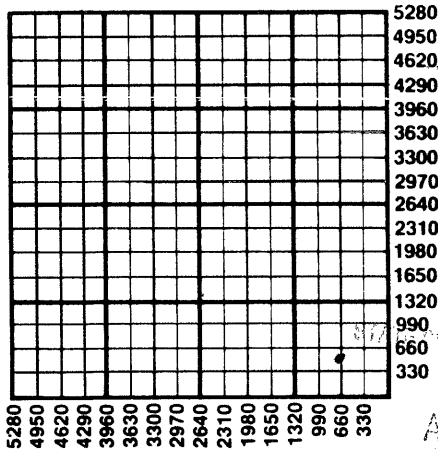

APR 18 1988  
 4-18-88  
 CONSERVATION DIVISION  
 Wichita, Kansas

State Corporation Commission of Kansas  
 Conservation Division  
 200 Colorado Derby Building  
 Wichita, Kansas 67202-1212  
 (316) 263-3238