

CARD MUST BE TYPED

State of Kansas

CARD MUST BE SIGNED

# NOTICE OF INTENTION TO DRILL

(see rules on reverse side)

Starting Date 9-12-87  
month day year

API Number 15—

065-22,399-00-00

OPERATOR: License # 3153  
Name Cardwell & Parker  
Address P. O. Box 1721  
City/State/Zip Plano, TX 75074  
Contact Person Ken Fletcher  
Phone 214/422-4995

NE/4NW/4NW/4 Sec. 12 Twp. 6 S, Rg. 23 East  
X West  
4950 Ft. from South Line of Section  
4290 Ft. from East Line of Section

(Note: Locate well on Section Plat on reverse side)

CONTRACTOR: License # 5107  
Name H-30 Drilling Co.  
City/State Wichita, Kansas

Nearest lease or unit boundary line 330 feet  
County Graham  
Lease Name Nighswonger Well # 12-1

Well Drilled For: Well Class: Type Equipment:  
 Oil  SWD  Infield  Mud Rotary  
 Gas  Inj  Pool Ext.  Air Rotary  
 OWWO  Expl  Wildcat  Cable

Ground surface elevation 2350 est. feet MSL  
Domestic well within 330 feet:  yes  no

Municipal well within one mile:  yes  no

If OWWO: old well info as follows:

Depth to bottom of fresh water. 200'

Depth to bottom of usable water 200' / 1150' (Base Dakota)

Surface pipe by Alternate: ~~X~~ 2

Surface pipe planned to be set 330'

Conductor pipe required

Projected Total Depth 3950 feet

Formation Arbuckle

I certify that well will comply with K.S.A. 55-101, et seq., plus eventually plugging hole to KCC specifications.

Date 8-28-87 Signature of Operator or Agent [Signature] Title Agent

For KCC Use:

Conductor Pipe Required \_\_\_\_\_ feet; Minimum Surface Pipe Required 250 feet per Alt. X 2


This Authorization Expires 3-1-88 Approved By [Signature] 8-31-87

Must be filed with the K.C.C. five (5) days prior to commencing well  
 This card void if drilling not started within six (6) months of date received by K.C.C.

**Important procedures to follow:**

1. Notify District office before setting surface casing.
2. Set surface casing by circulating cement to the top.
3. File completion forms ACO-1 with K.C.C. within 90 days of well completion, following instructions on ACO-1, side 1, and including copies of wireline logs.
4. Notify District office 48 hours prior to old well workover or re-entry.
5. Prior to filing Intent, prepare a proposed plugging plan in case well is D & A, then obtain approval of plan when calling district office prior to setting surface pipe.
6. Submit plugging report (CP-4) to K.C.C. after plugging is completed.
7. Obtain an approved injection docket number before disposing of salt water.
8. Notify K.C.C. within 10 days when injection commences or terminates.
9. If an alternate 2 completion, cement in the production pipe from below any usable water to surface within 120 days of spud date.

**A Regular Section of Land**  
**1 Mile = 5,280 Ft.**

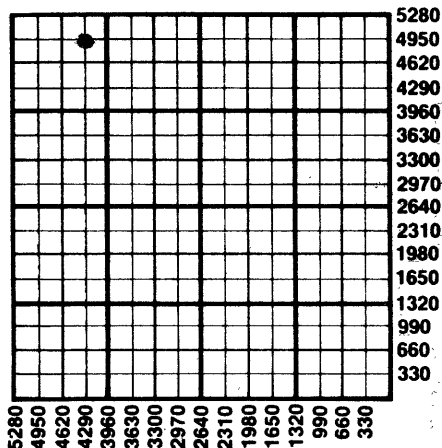

*8-31-87*

State Corporation Commission of Kansas  
 Conservation Division  
 200 Colorado Derby Building  
 Wichita, Kansas 67202  
 (316) 263-3238