

15-065-03332-0000

STATE OF KANSAS
STATE CORPORATION COMMISSION

Give All Information Completely
Make Required Affidavit
Mail or Deliver Report to:
Conservation Division
State Corporation Commission
800 Bittling Building
Wichita, Kansas


WELL PLUGGING RECORD

OR
FORMATION PLUGGING RECORD

Strike out upper line
when reporting plug-
ging off formations.

*Pd.
9/30/38
H.S.*

Graham County. Sec. 29 Twp. 6 Rge. (E) 23 (W)

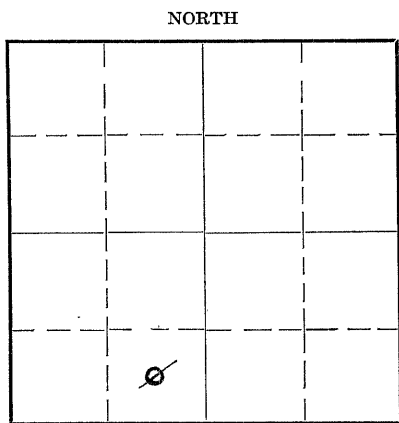

Location as "NE 1/4 NW 1/4 SW 1/4" or footage from lines C-SE SW

Lease Owner Duwe & Harris

Lease Name Jay S. Parker Well No. 1

Office Address 1004 Brown Bldg.

Character of Well (Completed as Oil, Gas or Dry Hole) Dry & Abandoned

Date, well completed 9-22-38, at 5:30 A.M. 193.8

Application for plugging filed 9-22-38 193.8

Application for plugging approved Same 193.

Plugging Commenced 9-22- 193.8

Plugging Completed 9-23-38 at 5:30 P.M. 193.

Reason for abandonment of well or producing formation Dry

If a producing well is abandoned, date of last production Dry 193.

Was permission obtained from the Conservation Division or its agents before plugging was commenced?

Agent, Edd Sheil

Name of Conservation Agent who supervised plugging of this well Edd Sheil

Producing formation none Depth to top Bottom Total Depth of Well 4202 Feet.

Show depth and thickness of all water, oil and gas formations. Steel Line 4206

OIL, GAS OR WATER RECORDS CASING RECORD

Formation	Content	From	To	Size	Put In	Pulled Out
sand	good fresh water	from 140 to 220		10 3/400	259'10"	none
				The above pipe was cemented with 250 sacks and it came around and covered the bottom of the cellar about one foot thick.		


Describe in detail the manner in which the well was plugged, indicating where the mud fluid was placed and the method or methods used in introducing it into the hole. If cement or other plugs were used, state the character of same and depth placed, from feet to feet for each plug set.

The hole was thoroughly circulated to free the same from cuttings and circulated with the heaviest rotary mud possible to handle with pump hole was refilled on way out at approx. 2500 ft. and 1000 ft.

Set bridge at 260, burlap bag filled with hay and some stone on the same mixed on floor and put in 12 sacks cement on bridge.

Set bridge at 20 ft. as above and mixed on floor and put in 4 sacks cement on bridge.

*Pd.
9/30/38
H.S.*
PLUGGING
FILE NO. 29-4-R-230
BOOK PAGE 35 LINE 5

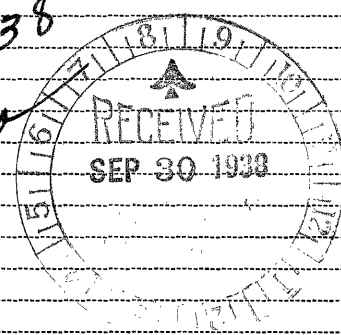

(If additional description is necessary, use BACK of this sheet)

Correspondence regarding this well should be addressed to Owners, or Cecil A. Prather 9-30-38
Address Box #65, Great Bend, Kansas.

STATE OF Kansas, COUNTY OF Sedgwick, ss.

John F. Duwe (Employee or owner or operator) of the above-described well, being first duly sworn on oath, says: That I have knowledge of the facts, statements, and matters herein contained and the log of the above-described well as filed and that the same are true and correct. So help me God.

(Signature) John F. Duwe
1004 Brown Bldg Wichita, Ks.
(Address)

SUBSCRIBED AND SWORN TO before me this 27th day of September, 1938.

My commission expires April 23, 1941.

Effie L. Foote
Notary Public.