


STATE OF KANSAS  
STATE CORPORATION COMMISSION

WELL PLUGGING RECORD

Give All Information Completely  
Make Required Affidavit  
Mail or Deliver Report to  
Conservation Division  
State Corporation Comm.  
245 North Water  
Wichita, KS 67202

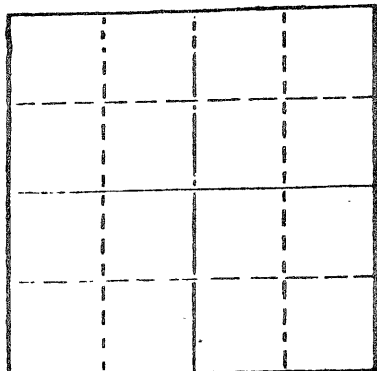

Locate well correctly on above  
Section Plat

Graham County. Sec. 27 Twp. 6S Rge. 23 ☒ W  
Location as "NE/CNW $\frac{1}{4}$ SW $\frac{1}{4}$ " or footage from lines \_\_\_\_\_  
C SW NE  
Lease Owner Jinkins Oil Company, Inc.  
Lease Name Honas Well No. 1  
Office Address 411 Farmers & Bankers Bldg., Wichita, KS 67202  
Character of Well (Completed as Oil, Gas or Dry Hole) \_\_\_\_\_

Dry Hole  
Date Well completed 12-29 19 77  
Application for plugging filed 12-29 19 77  
Application for plugging approved 12-29 19 77  
Plugging commenced 12-29 19 77  
Plugging completed 12-29 19 77  
Reason for abandonment of well or producing formation \_\_\_\_\_

Dry Hole  
If a producing well is abandoned, date of last production \_\_\_\_\_ 19 \_\_\_\_\_

Was permission obtained from the Conservation Division or  
its agents before plugging was commenced? Yes

Name of Conservation Agent who supervised plugging of this well Gilbert Balthazor  
Producing formation \_\_\_\_\_ Depth to top \_\_\_\_\_ Bottom \_\_\_\_\_ Total Depth of Well 3875  
Show depth and thickness of all water, oil and gas formations.

OIL, GAS OR WATER RECORDS

CASING RECORD

FORMATION	CONTENT	FROM	TO	SIZE	PUT IN	PULLED OUT
				8-5/8"	227	-0-

Describe in detail the manner in which the well was plugged, indicating where the mud fluid  
was placed and the method or methods used in introducing it into the hold. If cement or other  
plugs were used, state the character of same and depth placed, from \_\_\_\_\_ feet to  
\_\_\_\_\_ feet for each plug set.

Mud laden fluid 3875 to 1050'  
70 sks cement @ 1050'  
20 sks cement @ 215'  
10 sks cement @ 40'

RECEIVED  
STATE CORPORATION COMMISSION

JAN 04 1978

CONSERVATION DIVISION  
Wichita, Kansas

1-4-78

(If additional description is necessary, use BACK of this sheet)

Name of Plugging Contractor Emphasis Oil Operations

STATE OF KANSAS COUNTY OF RUSSELL, ss.  
Joe K. Branum (employee of owner) or (owner or operator)  
of the above-described well, being first duly sworn on oath, says: That I have knowledge of  
the facts, statements, and matters herein contained and the log of the above-described well  
as filed and that the same are true and correct. So help me God.

(Signature) Joe K. Branum

Box 506, Russell, KS 67665  
(Address)

SUBSCRIBED AND SWORN TO before me this 3rd day of January, 19 78

Patricia L. Clark

Notary Public.

My commission expires October 2, 1979

