


15-065-21011-00-00

STATE OF KANSAS  
STATE CORPORATION COMMISSION

WELL PLUGGING RECORD

Give All Information Completely  
Make Required Affidavit  
Mail or Deliver Report to  
Conservation Division  
State Corporation Comm.  
245 North Water  
Wichita, KS 67202

Graham County. Sec. 20 Twp. 6 S Rge. 25E/W  
Location as "NE/CNW $\frac{1}{4}$ SW $\frac{1}{4}$ " or footage from lines NW SW SW  
Lease Owner F & M Oil Company  
Lease Name Steichen Well No. 2  
Office Address 505 Union Center, Wichita, Kansas 67202  
Character of Well (Completed as Oil, Gas or Dry Hole) Dry Hole

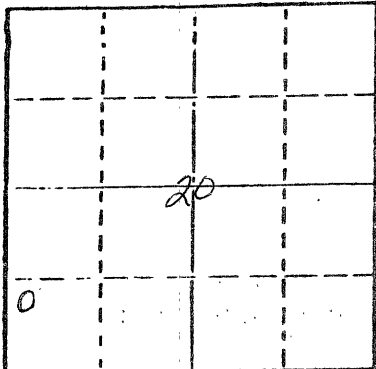

Locate well correctly on above  
Section Plot

Date Well completed April 19, 1978  
Application for plugging filed (verbally) April 19, 1978  
Application for plugging approved (verbally) April 19, 1978  
Plugging commenced April 19, 1978  
Plugging completed April 19, 1978  
Reason for abandonment of well or producing formation No commercial quantity of oil or gas encountered  
If a producing well is abandoned, date of last production 19

Was permission obtained from the Conservation Division or its agents before plugging was commenced? Yes

Name of Conservation Agent who supervised plugging of this well Gilbert Balthazor  
Producing formation \_\_\_\_\_ Depth to top \_\_\_\_\_ Bottom \_\_\_\_\_ Total Depth of Well 3880  
Show depth and thickness of all water, oil and gas formations.

OIL, GAS OR WATER RECORDS

CASING RECORD

FORMATION	CONTENT	FROM	TO	SIZE	PUT IN	PULLED OUT

Describe in detail the manner in which the well was plugged, indicating where the mud fluid was placed and the method or methods used in introducing it into the hold. If cement or other plugs were used, state the character of same and depth placed, from \_\_\_\_\_ feet to \_\_\_\_\_ feet for each plug set.

Set 1st plug at 800' with 70 sacks  
2nd plug at 240' with 20 sacks  
3rd plug at 40' with 20 sacks  
Cemented with 50/50 posmix, 6% gel.

RECEIVED  
STATE CORPORATION COMMISSION

APR 24 1978

CONSERVATION DIVISION  
Wichita, Kansas

4-24-78

(If additional description is necessary, use BACK of this sheet)

Name of Plugging Contractor Abercrombie Drilling, Inc.

STATE OF KANSAS COUNTY OF SEDGWICK ss.

Jack L. Partridge, Ass't. Sec.-Treas. (employee of owner) or (owner or operator) of the above-described well, being first duly sworn on oath, says: That I have knowledge of the facts, statements, and matters herein contained and the log of the above-described well as filed and that the same are true and correct. So help me God.

(Signature)

*Jack L. Partridge*

801 Union Center, Wichita, Kansas 67202  
(Address)

Subscribed AND SWORN to before me this 21st day of April, 19 78

NOTARY PUBLIC  
My commission expires July 21, 1979

*Sandra Richman*  
Sandra Richman

Notary Public.

PUBLIC