


15-065-00743-00-00

STATE OF KANSAS
STATE CORPORATION COMMISSION

Give All Information Completely
Make Required Affidavit
Mail or Deliver Report to:
Conservation Division
State Corporation Commission
800 Bitting Building
Wichita, Kansas

WELL PLUGGING RECORD

NORTH

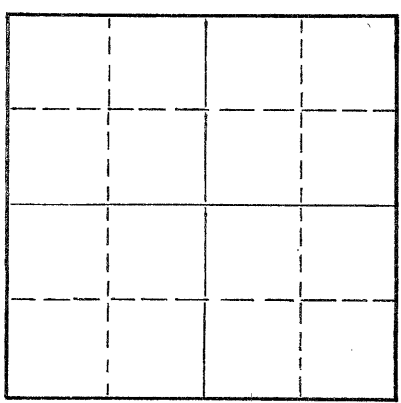

Locate well correctly on above
Section Plat

GRAHAM County. Sec. 19 Twp. 6 Rge. 25 (E) W (W)
Location as "NE/CNW/SW" or footage from lines SW SW NW
Lease Owner EMPIRE DRILLING COMPANY
Lease Name SIMONS Well No. 1
Office Address 407 BROWN BUILDING, WICHITA 2, KANSAS
Character of Well (completed as Oil, Gas or Dry Hole) DRY HOLE
Date well completed JULY 19 1955
Application for plugging filed JULY 19 1955
Application for plugging approved JULY 19 1955
Plugging commenced JULY 19 1955
Plugging completed JULY 19 1955
Reason for abandonment of well or producing formation DRY HOLE

If a producing well is abandoned, date of last production 19
Was permission obtained from the Conservation Division or its agents before plugging was commenced? YES

Name of Conservation Agent who supervised plugging of this well ELDON PETTY
Producing formation _____ Depth to top _____ Bottom _____ Total Depth of Well 3900 Feet
Show depth and thickness of all water, oil and gas formations.

OIL, GAS OR WATER RECORDS

CASING RECORD

FORMATION	CONTENT	FROM	TO	SIZE	PUT IN	PULLED OUT
SURFACE		0	335'	8 5/8"	335'	0

Describe in detail the manner in which the well was plugged, indicating where the mud fluid was placed and the method or methods used in introducing it into the hole. If cement or other plugs were used, state the character of same and depth placed, from _____ feet to _____ feet for each plug set.

BOTTOM PLUG AT 325' WITH 1/2 SACK HULLS AND 15 SACKS CEMENT
TOP PLUG AT 40' WITH 1/2 SACK HULLS AND 10 SACKS CEMENT

CONSERVATION DIVISION
Wichita, Kansas

(If additional description is necessary, use BACK of this sheet)

Name of Plugging Contractor EMPIRE DRILLING COMPANY
Address 407 BROWN BUILDING, WICHITA 2, KANSAS

STATE OF KANSAS, COUNTY OF SEDGWICK, ss.
I, DAN J. KORNFELD (employee of owner) or (owner or operator) of the above-described well, being first duly sworn on oath, says: That I have knowledge of the facts, statements, and matters herein contained and the log of the above-described well as filed and that the same are true and correct. So help me God.

(Signature) DAN J. KORNFELD
407 BROWN BUILDING, WICHITA 2, KANSAS
(Address)

SUBSCRIBED AND SWORN TO before me this 21st day of JULY, 1955

[Signature] Notary Public.

My commission expires DECEMBER 10, 1956

PLUGGING
FILE SEC 19 7 6 R 25W
BOOK PAGE 136 LINE 9