


STATE OF KANSAS  
STATE CORPORATION COMMISSION

15-005-00940-00-00

Give All Information Completely  
Make Required Affidavit  
Mail or Deliver Report to:  
Conservation Division  
State Corporation Commission  
211 No. Broadway  
Wichita, Kansas

WELL PLUGGING RECORD

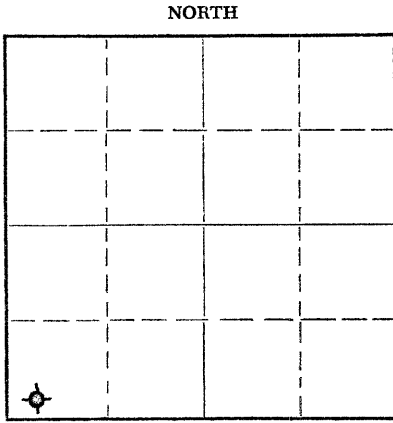

Locate well correctly on above Section Plat

Graham County, Sec. 13 Twp. 6 Rge. 25 (E) W (W)  
Location as "NE/CNW/SW" or footage from lines SW SW SW  
Lease Owner D. G. Hansen  
Lease Name Carpenter Well No. 1  
Office Address Logan, Kansas  
Character of Well (completed as Oil, Gas or Dry Hole) Dry Hole  
Date well completed March 9 19 57  
Application for plugging filed March 9 19 57  
Application for plugging approved March 9 19 57  
Plugging commenced March 9 19 57  
Plugging completed March 9 19 57  
Reason for abandonment of well or producing formation Too low structually

If a producing well is abandoned, date of last production \_\_\_\_\_ 19\_\_\_\_  
Was permission obtained from the Conservation Division or its agents before plugging was commenced? Yes

Name of Conservation Agent who supervised plugging of this well Eldon Petty, Hays, Kansas  
Producing formation \_\_\_\_\_ Depth to top \_\_\_\_\_ Bottom \_\_\_\_\_ Total Depth of Well 4310 Feet  
Show depth and thickness of all water, oil and gas formations.

OIL, GAS OR WATER RECORDS CASING RECORD

FORMATION	CONTENT	FROM	TO	SIZE	PUT IN	PULLED OUT
				8-5/8"	263'	none

Describe in detail the manner in which the well was plugged, indicating where the mud fluid was placed and the method or methods used in introducing it into the hole. If cement or other plugs were used, state the character of same and depth placed, from \_\_\_\_\_ feet to \_\_\_\_\_ feet for each plug set.

Filled hole with heavy mud to 258'. Set plug. Put in 1/2 sack Hulls & 15 sacks cement. Filled with heavy mud to 40'. Set plug. Filled to top with 1/2 sack Hulls & 10 sacks cement.

(If additional description is necessary, use BACK of this sheet)  
Name of Plugging Contractor C-G Drilling Co.  
Address 107 Rule Building, Wichita, Kansas

STATE OF KANSAS, COUNTY OF SEDGWICK, ss.  
Jay H. Galloway (employee of owner) or (owner or operator) of the above-described well, being first duly sworn on oath, says: That I have knowledge of the facts, statements, and matters herein contained and the log of the above-described well as filed and that the same are true and correct. So help me God.

(Signature) Jay H. Galloway  
107 Rule Bldg.  
(Address)

SUBSCRIBED AND SWORN TO before me this 11th day of March, 19 57

My commission expires May 20, 1959  
Vicky Jacobs Notary Public.

PLUGGING  
FILE SEC. 13 T. 6 R. 25W  
BOOK PAGE 147 LINE 14

RECEIVED  
STATE CORPORATION COMMISSION  
MAR 15 1957  
3-15-57  
CONSERVATION DIVISION  
Wichita, Kansas