

15-065-00461-00-00

STATE OF KANSAS
STATE CORPORATION COMMISSION


Give All Information Completely
Make Required Affidavit
Mail or Deliver Report to:
Conservation Division
State Corporation Commission
800 Biting Building
Wichita, Kansas

WELL PLUGGING RECORD

Graham County, Sec. 5 Twp. 6S Rge. 25 (E) (W)

Location as "NE/CNW $\frac{1}{4}$ SW $\frac{1}{4}$ " or footage from lines NW NW SW
Lease Owner National Cooperative Refinery Association
Lease Name Bangle Well No. 1
Office Address 305 Rule Building, Wichita, Kansas
Character of Well (completed as Oil, Gas or Dry Hole) Dry Hole
Date well completed April 14, 1954
Application for plugging filed April 15, 1954
Application for plugging approved April 16, 1954
Plugging commenced April 14, 1954
Plugging completed April 14, 1954
Reason for abandonment of well or producing formation Dry Hole

NORTH

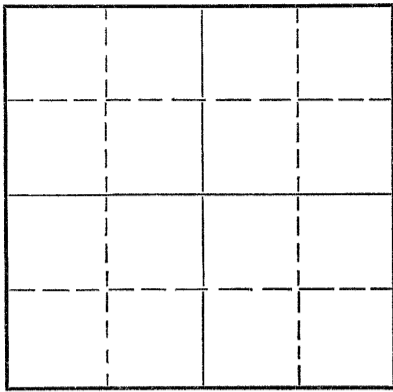

Locate well correctly on above
Section Plat

If a producing well is abandoned, date of last production 19
Was permission obtained from the Conservation Division or its agents before plugging was commenced? Yes

Name of Conservation Agent who supervised plugging of this well Eldon Petty
Producing formation _____ Depth to top _____ Bottom _____ Total Depth of Well 4034 Feet
Show depth and thickness of all water, oil and gas formations.

OIL, GAS OR WATER RECORDS

CASING RECORD

FORMATION	CONTENT	FROM	TO	SIZE	PUT IN	PULLED OUT
				8 5/8"	272'	None-cemented

Describe in detail the manner in which the well was plugged, indicating where the mud fluid was placed and the method or methods used in introducing it into the hole. If cement or other plugs were used, state the character of same and depth placed, from _____ feet to _____ feet for each plug set.

Mudded hole to 260', set plug with 1/2 sack of hulls plus 15 sacks of cement. Mudded hole to 40', set plug with 1/2 sack of hulls plus 10 sacks cement on up to base of cellar.

(If additional description is necessary, use BACK of this sheet)

Name of Plugging Contractor M. B. Armer
Address 710 Petroleum Building, Wichita, Kansas

STATE OF Kansas, COUNTY OF Sedgwick, ss.
C. R. Sears (employee of owner) or (owner or operator) of the above-described well, being first duly sworn on oath, says: That I have knowledge of the facts, statements, and matters herein contained and the log of the above-described well as filed and that the same are true and correct. So help me God.

(Signature) C.R. Sears
305 Rule Building, Wichita, Kansas
(Address)

SUBSCRIBED AND SWORN TO before me this 19 day of April, 1954

My commission expires June 30, 1954

24-7368-S 3-53-20M

RECEIVED
STATE OF KANSAS
C. Orville May, Notary Public.

APR 20 1954

CONSERVATION DIVISION
Wichita, Kansas

4-20-54

PLUGGING
MAY 5 16 1954
WICHITA
WELL NO. 27 LINE 25