SIDE ONE

STATE CORPORATION COMMISSION OF KANSAS
OIL & GAS CONSERVATION DIVISION
WELL COMPLETION OR RECOMPLETION FORM
ACO-1 WELL HISTORY
DESCRIPTION OF WELL AND LEASE

3

API NO. 15-065-22,508-00-00

County Graham

NE SE NW Sec. 34 Twp. 6S Rge. 22 __ East X West

3630 Ft North from Southeast Corner of Section
2970 Ft West from Southeast Corner of Section
(Note: Locate well in section plat below)

Lease Name Davis Well # 2

Field Name ~~Worchester~~ Red Sun

Producing Formation Lansing - Kansas City

Elevation: Ground 2286' KB 2291'

Operator: License # 6030
Name Ainsworth Operating Company
Address Box 1269
City/State/Zip Colorado Springs, CO 80901

Purchaser Koch Oil Co.

Operator Contact Person Terry Hidy
Phone (719) 576-5300

Contractor: License # 5422
Name Abercrombie Drilling, Inc.

Wellsite Geologist Kent Roberts
Phone 316-262-5300

Designate Type of Completion
X New Well __ Re-Entry __ Workover
X Oil __ SWD __ Temp Abd
__ Gas __ Inj __ Delayed Comp.
~~X Dry~~ __ Other (Core, Water Supply etc.)

If OWWO: old well info as follows:
Operator
Well Name
Comp. Date Old Total Depth

RECEIVED
STATE CORPORATION COMMISSION
3-15-89
MAR 15 1989
CONSERVATION DIVISION
Wichita, Kansas

Section Plat

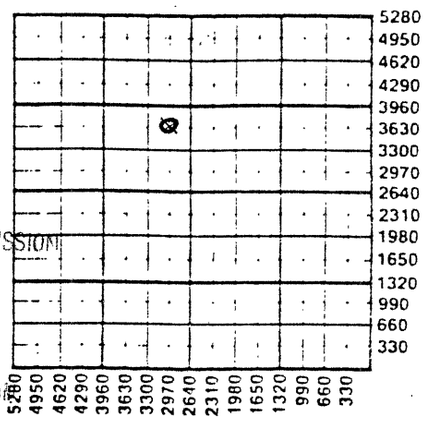

WATER SUPPLY INFORMATION
Disposition of Produced Water: __ Disposal
Docket # __ Repressuring

WELL HISTORY
Drilling Method:
X Mud Rotary __ Air Rotary __ Cable

1-23-89	2-03-89	2-18-89
Spud Date	Date Reached TD	Completion Date

3920'	
Total Depth	PBTD

Amount of Surface Pipe Set and Cemented at 273 feet
Multiple Stage Cementing Collar Used? X Yes __ No
If yes, show depth set 1950 feet
If alternate 2 completion, cement circulated
from 1950 feet depth to suface w/ 350 SX cmt
Cement Company Name Halliburton
Invoice # 791976
4-4-89

Questions on this portion of the ACO-1 call:
Water Resources Board (913) 296-3717
Source of Water:
Division of Water Resources Permit # T89-043

X Groundwater 4620 Ft North from Southeast Corner
(Well) 5200 Ft West from Southeast Corner of
Graham Sec 10 Twp 7S Rge 22 __ East X West

__ Surface Water Ft North from Southeast Corner
(Stream, pond etc) Ft West from Southeast Corner
Sec Twp Rge __ East __ West

X Other (explain) Supplied by Contractor
(purchased from city, R.W.D. #)

INSTRUCTIONS: This form shall be completed in triplicate and filed with the Kansas Corporation Commission, 200 Colorado Derby Building, Wichita, Kansas 67202, within 120 days of the spud date of any well. Rule 82-3-130, 82-3-107 and 82-3-106 apply.
Information on side two of this form will be held confidential for a period of 12 months if requested in writing and submitted with the form. See rule 82-3-107 for confidentiality in excess of 12 months.
One copy of all wireline logs and drillers time log shall be attached with this form. Submit CP-4 form with all plugged wells. Submit CP-111 form with all temporarily abandoned wells.

All requirements of the statutes, rules and regulations promulgated to regulate the oil and gas industry have been fully complied with and the statements herein are complete and correct to the best of my knowledge.

Signature Kent Roberts
Title Kent Roberts - Geologists Date 3-10-89

Subscribed and sworn to before me this 10th day of March 19 89
Notary Public Janet Harvey
Janet Harvey
Date Commission Expires March 13, 1991

K.C.C. OFFICE USE ONLY
F ✓ Letter of Confidentiality Attached
C ✓ Wireline Log Received
C __ Drillers Timelog Received
Distribution
✓ KCC __ SWD/Rep __ NGPA
✓ KGS __ Plug __ Other (Specify)

Sec. 34 Twp. 6 Rge. 22 W

3-15-89 K4

Form ACO-1 (5-86)