

IN ALL CASES PLOT THE INTENDED WELL ON THE PLAT BELOW

Show the relationship to other wells or facilities proposed to be serviced by the intended cathodic borehole. Please show all the wells, existing cathodic boreholes, pipelines or facilities within 1/2 mile of the proposed borehole.

API NO. 15- _____
 OPERATOR Northern Natural Gas Co.
 LEASE M6 50B-1
 WELL NUMBER #1
 FACILITY NAME M6 50B-1 Well #1

LOCATION OF WELL: COUNTY Pawnee
1562' feet from south/north line of section
475' feet from east west line of section
 SECTION 31 TWP 20S RG 20W

SPOT: QTR/QTR/QTR/QTR OF ACREAGE
 - NE - SE - NE


X
 IS SECTION _____ REGULAR or _____ IRREGULAR
IF SECTION IS IRREGULAR, LOCATE WELL FROM NEAREST CORNER BOUNDARY.

Section corner used: _____ NE _____ NW _____ SE _____ SW

PLAT


(Show location of intended cathodic borehole.)

(Show footage from nearest lease, unit or outside section boundary line.)

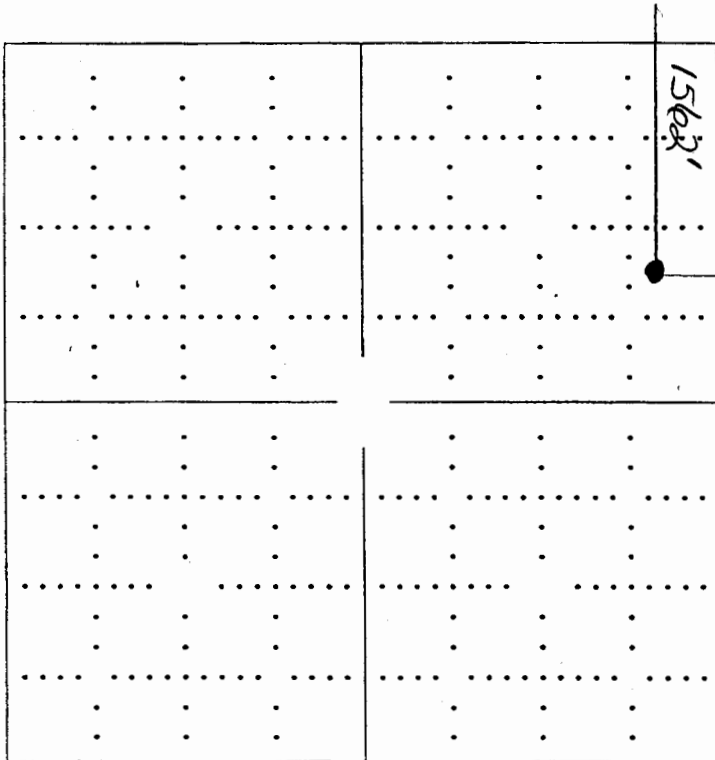

RECEIVED
 KANSAS CORPORATION COMMISSION
APR 22 2005
 CONSERVATION DIVISION
 WICHITA, KS

Section 31

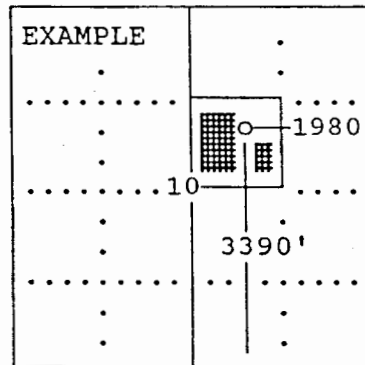

SEWARD CO.

In plotting the proposed location of the well, you must show:

- 1) The manner in which you are using the depicted plat by identifying section lines, i.e. 1 section, 1 section with 8 surrounding sections, 4 sections, etc.;
- 2) the distance of the proposed drilling location from the section's south/north and east/west; and
- 3) the distance to the nearest lease, unit or outside section boundary line.