

CARD MUST BE TYPED

State of Kansas  
NOTICE OF INTENTION TO DRILL  
HUGOTON INFILL

CARD MUST BE SIGNED

EFFECTIVE DATE 4-6-05

SGA-NO

Starting Date MAY 01 2005 API Number 15- 093-21760-00-00  
month day year IS SECTION X REGULAR IRREGULAR

OPERATOR: License # 5952  
Name BP AMERICA PRODUCTION COMPANY  
Address P. O. BOX 3092, WL1, RM 3.201  
City/State/Zip HOUSTON, TX 77253-3092  
Contact Person SUE SELLERS  
Phone (281)366-2052

NE SW SW Sec 18 Twp 23 S, Rg 35 W  
1250 S Ft. from South Line of Section  
1250 W Ft. from East Line of Section

CONTRACTOR License # 5382-33375  
Name CHEYENNE DRILLING  
City/State

Note: Attach acreage attribution plat locating both Chase (Hugoton) wells  
Total number of acres attributed to unit 640

Well Drilled as: X New      Recompletion      OWWO  
Projected Total Depth 2850 feet  
Formation

Nearest producing well from  
same common source of supply 1787 feet  
Nearest lease or unit boundary line 1250 feet

If OWWO or Recompletion: old well info as follows:  
Operator  
Well Name  
Comp. Date Old Total Depth

County KEARNY  
Lease Name MADDUX A Well # 2HI  
Ground surface elevation 3063 feet MSL  
Depth to bottom of fresh water 280  
Depth to bottom of usable water 900  
Surface pipe by Alternate: 1 - 2 X  
Surface pipe planned to be set 300' MIN  
Water Source for Drilled Operations:  
DWR Permit #: well farm pond X other

I certify that well will comply with K.S.A. 55-101, et seq., plus eventually plugging hole to KCC specifications.  
Date MARCH 30, 2005 Signature of Operator or Agent Sue Sellers Title

REGULATORY STAFF  
ASSISTANT

For KCC Use:  
Conductor Pipe Required NONE feet; Minimum Surface Pipe Required 300' feet per Alt. 2  
This Authorization Expires 10-2-05 Approved By RJP 4-1-05

9/95


Must be filed with K.C.C. five (5) days prior to commencing well  
This card void if drilling not started within six (6) months of date received by K.C.C.

RECEIVED  
KANSAS CORPORATION COMMISSION

APR 01 2005

CONSERVATION DIVISION  
WICHITA, KS

A Regular Section of Land  
1 Mile = 5,280 Ft.

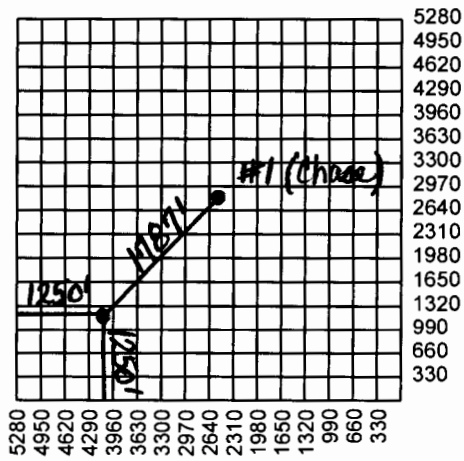

- Important procedures to follow:
1. Notify District office before setting surface casing.
  2. Set surface casing by circulating cement to the top.
  3. File completion forms ACO-1 with K.C.C. within 120 days of well spud date, following instructions on ACO-1, side 1, and including copies of wireline logs.
  4. Notify District office 48 hours prior to old well workover or re-entry.
  5. Submit plugging report (CP-4) to K.C.C. after plugging is completed.
  6. If an alternate 2 completion, cement in the production pipe from below any useable water to surface within 120 day of spud date.

State Corporation Commission of Kansas  
Conservation Division  
130 S. Market Room 2078  
Wichita, Kansas 67202-1212  
(316) 337-6231