

CARD MUST BE TYPED

KCC. DIST #1

State of Kansas

CARD MUST BE SIGNED

EFFECTIVE DATE 4-17-05

NOTICE OF INTENTION TO DRILL HUGOTON INFILL

SGA - Yes

Starting Date MAY 01 2005 month day year

API Number 15- 129-21752-00-00

IS SECTION X REGULAR IRREGULAR

OPERATOR: License # 5952 (6-30-05)

SE SE NW NW Sec 10 Twp 31 S, Rg 40 W

Name BP AMERICA PRODUCTION COMPANY
Address P. O. BOX 3092, WL1, RM 3.201
City/State/Zip HOUSTON, TX 77253-3092
Contact Person SUE SELLERS
Phone (281)366-2052

1250 N Ft. from South Line of Section
1250 W Ft. from East Line of Section

Note: Attach acreage attribution plat locating both Chase (Hugoton) wells
Total number of acres attributed to unit 640

CONTRACTOR License # 5382 33375 (2-28-06)

Nearest producing well from same common source of supply 2063 feet
Nearest lease or unit boundary line 1250 feet

Name CHEYENNE DRILLING LP
City/State
Well Drilled as: X New Recompletion OWWO
Projected Total Depth 2650 feet
Formation

County MORTON
Lease Name SMITH A Well # 3HI
Ground surface elevation 3273 feet MSL
Depth to bottom of fresh water 440
Depth to bottom of usable water 580

If OWWO or Recompletion: old well info as follows:

Surface pipe by Alternate: 1 X 2
Surface pipe planned to be set 600' min ALT-1
Water Source for Drilled Operations:
DWR Permit #: well farm pond X other

Operator
Well Name
Comp. Date Old Total Depth

I certify that well will comply with K.S.A. 55-101, et seq., plus eventually plugging hole to KCC specifications.

Date MARCH 30, 2005 Signature of Operator or Agent Sue Sellers

REGULATORY STAFF ASSISTANT

For KCC Use:

Conductor Pipe Required NONE feet; Minimum Surface Pipe Required 600 feet per Alt 1 2
This Authorization Expires 10-12-05 Approved By RJP 4-12-05

9/95

NOTE: 600' ALT-1 MIN. SURFACE CASING


RECEIVED KANSAS CORPORATION COMMISSION

APR 01 2005

Must be filed with K.C.C. five (5) days prior to commencing well
This card void if drilling not started within six (6) months of date received by K.C.C.

CONSERVATION DIVISION WICHITA, KS

A Regular Section of Land
1 Mile = 5,280 Ft.

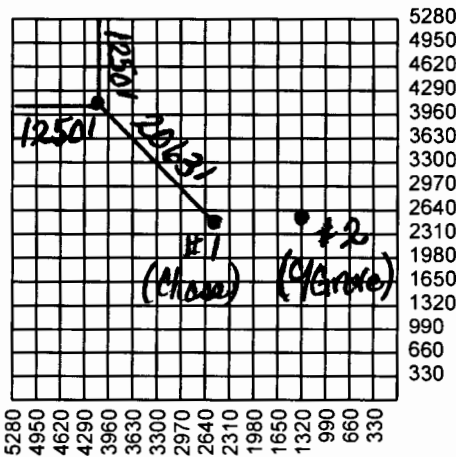

Important procedures to follow:

- 1. Notify District office before setting surface casing.
2. Set surface casing by circulating cement to the top.
3. File completion forms ACO-1 with K.C.C. within 120 days of well spud date, following instructions on ACO-1, side 1, and including copies of wireline logs.
4. Notify District office 48 hours prior to old well workover or re-entry.
5. Submit plugging report (CP-4) to K.C.C. after plugging is completed.
6. If an alternate 2 completion, cement in the production pipe from below any useable water to surface within 120 day of spud date.

State Corporation Commission of Kansas
Conservation Division
130 S. Market Room 2078
Wichita, Kansas 67202-1212
(316) 337-6231